

15-193-20136-00-00

STATE OF KANSAS
STATE CORPORATION COMMISSION

WELL PLUGGING RECORD

Give All Information Completely
Make Required Affidavit
Mail or Deliver Report to
Conservation Division
State Corporation Comm.
245 North Water
Wichita, KS 67202

Thomas County. Sec. 28 Twp. 9S Rge. 33W E/W
Location as "NE/CNW $\frac{1}{4}$ SW $\frac{1}{4}$ " or footage from lines

C NE NW
Lease Owner ISERN Petroleum Co.
Lease Name HERBAL "C" Well No. 1
Office Address Box 486, Ellinwood, Kansas 67526
Character of Well (Completed as Oil, Gas or Dry Hole)
Dry Hole

Date Well completed 5-16-1977
Application for plugging filed (Verbally) 5-16-1977
Application for plugging approved (Verbally) 5-16-1977
Plugging commenced 5-16-1977
Plugging completed 5-16-1977

Reason for abandonment of well or producing formation
No commercial quantity of oil or gas encountered
If a producing well is abandoned, date of last production 19

Was permission obtained from the Conservation Division or
its agents before plugging was commenced? Yes

Name of Conservation Agent who supervised plugging of this well
Producing formation _____ Depth to top _____ Bottom _____ Total Depth of Well _____
Show depth and thickness of all water, oil and gas formations.

OIL, GAS OR WATER RECORDS

CASING RECORD

FORMATION	CONTENT	FROM	TO	SIZE	PUT IN	PULLED OUT

Describe in detail the manner in which the well was plugged, indicating where the mud fluid was placed and the method or methods used in introducing it into the hold. If cement or other plugs were used, state the character of same and depth placed, from _____ feet to _____ feet for each plug set.

T.D. 4775'
Set 1st plug at 1250' with 70 sx.,
2nd plug at 300' with 20 sx.
3rd plug at 40' with 10 sx.

Plug was down at 11:30 a.m. 5-16-77.

(If additional description is necessary, use BACK of this sheet)

Name of Plugging Contractor Abercrombie Drilling, Inc.

STATE OF Kansas COUNTY OF Sedgwick, ss.
Jack L. Partridge, Asst. Sec.-Treas. (employee of owner) or (owner or operator)
of the above-described well, being first duly sworn on oath, says: That I have knowledge of the facts, statements, and matters herein contained and the log of the above-described well as filed and that the same are true and correct. So help me God.


(Signature) Jack L. Partridge
801 Union Center, Wichita, Kansas 67202
(Address)

SUBSCRIBED AND SWORN TO before me this 31st day of May, 1977

My commission expires _____

RECEIVED
Kathy S. Goertz
STATE CORPORATION COMMISSION
Notary Public.

JUN 06 1977
06-06-1977
CONSERVATION DIVISION
Wichita, Kansas

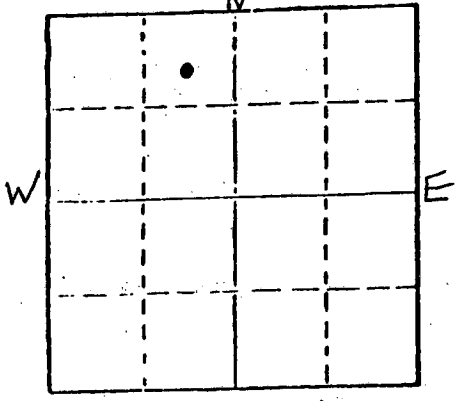

Locate well correctly on above Section Plat

15-193-20136-00-00

CONTRACTOR'S WELL LOG

OPERATOR: ISERN Petroleum Co.
 CONTRACTOR: Abercrombie Drilling, Inc.
 WELL NAME: HERBAL "C" #1
 LOCATION: C NE NW, Section 28-9S-33W
 Thomas County, Kansas
 SPUD DATE: 5-06-77
 COMPLETION DATE: 5-16-77.

0	210	Surface Dirt & Sand
210	310	Sand
310	358	Shale
358	387	Sand
387	1677	Sand & Shale
1677	2733	Sand & Shale
2733	2758	Anhydrite
2758	3053	Sand & Shale
3053	3680	Shale & Lime
3680	4125	Lime & Shale
4125	4215	Sand & Shale
4215	4310	Lime & Shale
4310	4775	Lime
	4775	Rotary Total Depth

Spud hole at 5:15 p.m. 5-06-77. Drilled 358' of 12 1/4" hole. Ran 7 jts. of 8 5/8" used 28# Surface Casing. (Tally 348.90' - Threads on) Set at 352.65'. Cemented with 200 sx. of common Sun Cement, 2% gel, 3% Ca. Cl. Cement did circulate. Plug was down at 3:00 a.m. 5-07-77.

4775' T.D., Set 1st plug at 1250' with 70 sx., 2nd plug at 300' with 20 sx., 3rd plug at 40' with 10 sx. Plug was down at 11:30 a.m. 5-16-77.

SAMPLE TOPS:

Anhydrite 2733'
 B/Anhydrite 2758'

STATE OF KANSAS)
) SS
 COUNTY OF SEDGWICK)

Jack L. Partridge, Assistant Secretary-Treasurer of Abercrombie Drilling, Inc., does hereby state that the above and foregoing is a true and correct copy of the log of the HERBAL "C" #1, C NE NW, Section 28-9S-33W, Thomas County, Kansas.

ABERCROMBIE DRILLING, INC.

BY *Jack L. Partridge*
 Jack L. Partridge, Asst. Sec.-Treas.

Subscribed and sworn to before me, a Notary Public, in and for the aforesaid county and state as of this 31st day of May, 1977.

RECEIVED
 STATE CORPORATION COMMISSION



JUN 06 1977
Kathy S. Goertz
 Kathy S. Goertz, Notary Public
 CONSERVATION DIVISION
 Wichita, Kansas