

15-193-20073-00-00

FORM CP-4

STATE OF KANSAS
STATE CORPORATION COMMISSION
CONSERVATION DIVISION
P. O. BOX 17027
WICHITA, KANSAS 67217

WELL PLUGGING RECORD

Thomas County, Sec. 13 Twp. 9S Rge. XXX 35(W)

Location as "NE/CNW/SW" or footage from lines SE NW

Lease Owner Thunderbird Drilling, Inc.

Lease Name WEILAND "B" Well No. 1

Office Address 7701 E. Kellogg Suite 780 Wichita, KS 67202

Character of Well (completed as Oil, Gas or Dry Hole) Dry Hole

Date well completed March 6 1976

Application for plugging filed (verbally) March 6 1976

Application for plugging approved (verbally) March 6 1976


Plugging commenced March 6 1976

Plugging completed March 6 1976

Reason for abandonment of well or producing formation No commercial quantity of oil or gas encountered.

If a producing well is abandoned, date of last production 19

Was permission obtained from the Conservation Division or its agents before plugging was commenced? yes

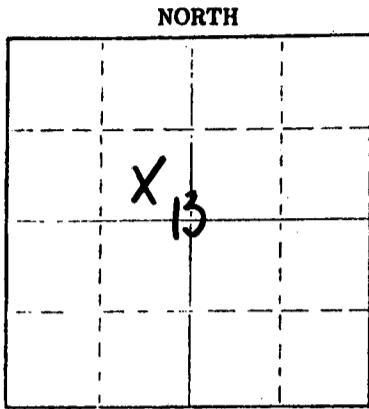

Locate well correctly on above Section Plat

Name of Conservation Agent who supervised plugging of this well Gilbert Balthazor

Producing formation Depth to top Bottom Total Depth of Well 4900'

Show depth and thickness of all water, oil and gas formations.

OIL, GAS OR WATER RECORDS

CASING RECORD

Table with 7 columns: FORMATION, CONTENT, FROM, TO, SIZE, PUT IN, PULLED OUT. Row 1: 8 5/8", 252.85', None.

Describe in detail the manner in which the well was plugged, indicating where the mud fluid was placed and the method or methods used in introducing it into the hole. If cement or other plugs were used, state the character of same and depth placed, from feet to feet for each plug set.

1st Plug set @ 2075' with 70 sacks
2nd Plug set @ 250' with 20 sacks
3rd Plug set @ 40' with 10 sacks

Plug was down @ 9:30 a.m. March 6, 1976
STATE PLUGGER: Gilbert Balthazor

Name of Plugging Contractor (If additional description is necessary, use BACK of this sheet) Abercrombie Drilling, Inc.
Address 801 Union Center Wichita, KS 67202

STATE OF Kansas COUNTY OF Sedgwick ss.
Jerry A. Langrehr-Exec. V.P. (employee of owner) or (owner or operator) of the above-described


well, being first duly sworn on oath, says: That I have knowledge of the facts, statements, and matters herein contained and the log of the above-described well as filed and that the same are true and correct. So help me God.

(Signature) Jerry A. Langrehr

801 Union Center, Wichita, KS 67202

SUBSCRIBED AND SWORN TO before me this 23rd day of March 1976

My commission expires February 18, 1980 Diane Steincamp Notary Public.

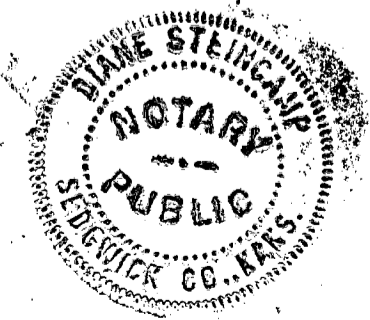

RECEIVED STATE CORPORATION COMMISSION

MAR 24 1976
03-24-1976
CONSERVATION DIVISION
Wichita, Kansas

CONTRACTOR'S WELL LOG

15-193 - 20073 - 00 - 00

OPERATOR: Thunderbird Drilling, Inc.
 CONTRACTOR: Abercrombie Drilling, Inc.
 WELL NAME: WEILAND "B" #1
 LOCATION: SE NW Section 13-9S-35W
 Thomas County, Kansas
 SPUD DATE: February 26, 1976
 COMPLETION DATE: March 6, 1976

0	150	Surface sand & clay
150	210	Sand
210	2783	Shale
2783	2813	Anhydrite
2813	3630	Shale
3630	3929	Shale & lime
3929	4175	Lime & shale
4175	4728	Lime
4728	4816	Lime & shale
4816	4900	Lime
	4900	Rotary Total Depth

Drilled 255' of 12 1/4" hole. Ran 6 jts. of used 8 5/8" 28# casing, tallied 244.85'. Set @ 252.85' with 190 sx. cement, 2% gel, 3% ca. cl. Allied cement. Cement did circulate. Plug was down @ 8:30 p.m. February 26, 1976.

Plugged and Abandoned: 1st Plug was Set @ 2075' with 70 sx. cement; 2nd Plug was Set @ 250' with 20 sx. cement; 3rd Plug was Set @ 40' with 10 sx. cement. State Plugger: Gilbert Balthazor 50/50 Posmix cement Plug was down @ 9:30 a.m. March 6, 1976.

SAMPLE TOPS:

Anhydrite 2783'
 B/Anhydrite 2813'

RECEIVED
 STATE CORPORATION COMMISSION
 03-24-1976
 MAR 24 1976

STATE OF KANSAS)
) SS
 COUNTY OF SEDGWICK)

CONSERVATION DIVISION
 Wichita, Kansas

Jerry A. Langrehr-Executive Vice President of Abercrombie Drilling, Inc., does hereby state that the above and foregoing is a true and correct copy of the log of the WEILAND "B" #1 SE NW Section 13-9S-35W Thomas County, Kansas.

ABERCROMBIE DRILLING, INC.

By: Jerry A. Langrehr
 Jerry A. Langrehr-Exec. V.P.

Subscribed and sworn to before me, a Notary Public, in and for the aforesaid county and state as of this 11th day of March, 1976.

Diane Steincamp
 Diane Steincamp - Notary Public

My Commission Expires: February 18, 1980

