

15-193-20074-00-00


FORM CP-4

STATE OF KANSAS  
STATE CORPORATION COMMISSION  
CONSERVATION DIVISION  
P. O. BOX 17027  
WICHITA, KANSAS 67217

WELL PLUGGING RECORD

Thomas County, Sec. 4 Twp. 9S Rge. 35 (W)

Location as "NE/CNW/SW" or footage from lines SE SW  
Lease Owner Thunderbird Drilling, Inc.  
Lease Name NTKL Well No. #1  
Office Address 7701 E. Kellogg, Suite 780, P. O. Box 18407, Wichita, Ks.  
Character of Well (completed as Oil, Gas or Dry Hole) Dry Hole  
Date well completed March 20, 1976  
Application for plugging filed (verbally) March 20, 1976  
Application for plugging approved (verbally) March 20, 1976  
Plugging commenced March 20, 1976  
Plugging completed March 20, 1976  
Reason for abandonment of well or producing formation No commercial quantity or oil or gas encountered.  
If a producing well is abandoned, date of last production 19  
Was permission obtained from the Conservation Division or its agents before plugging was commenced? Yes

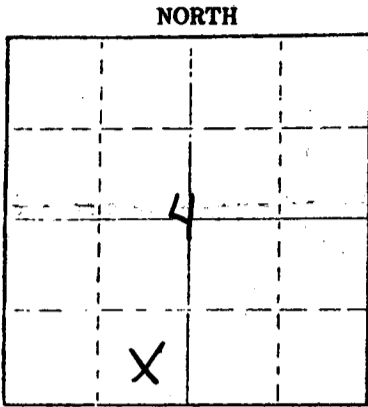

Locate well correctly on above Section Plot

Name of Conservation Agent who supervised plugging of this well Gilbert Balthazor  
Producing formation \_\_\_\_\_ Depth to top \_\_\_\_\_ Bottom \_\_\_\_\_ Total Depth of Well 4915'  
Show depth and thickness of all water, oil and gas formations.

OIL, GAS OR WATER RECORDS

CASING RECORD

FORMATION	CONTENT	FROM	TO	SIZE	PUT IN	PULLED OUT
				8 5/8"	245.27'	none

Describe in detail the manner in which the well was plugged, indicating where the mud fluid was placed and the method or methods used in introducing it into the hole. If cement or other plugs were used, state the character of same and depth placed, from \_\_\_\_\_ feet to \_\_\_\_\_ feet for each plug set.

RECEIVED

1st Plug was Set @ 1700' with 70 sx. cement  
2nd Plug was Set @ 250' with 20 sx. cement  
3rd Plug was Set @ 40' with 10 sx. cement

MAR 25 1976  
03-25-1976  
CONSERVATION DIVISION  
Wichita, Kansas

(If additional description is necessary, use BACK of this sheet)  
Name of Plugging Contractor Abercrombie Drilling, Inc.  
Address 801 Union Center, Wichita, Kansas 67202


STATE OF KANSAS COUNTY OF SEDGWICK  
Jerry A. Langrehr-Exec. V.P. (employee of owner) or (owner or operator) of the above-described

well, being first duly sworn on oath, says: That I have knowledge of the facts, statements, and matters herein contained and the log of the above-described well as filed and that the same are true and correct. So help me God.

(Signature) Jerry A. Langrehr  
801 Union Center, Wichita, Kansas 67202 (Address)

SUBSCRIBED AND SWORN TO before me this 24th day of March, 1976

My commission expires February 18, 1980  
Diane Steincamp Notary Public

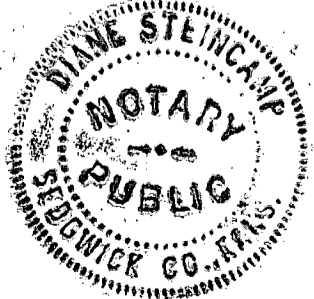

CONTRACTOR'S WELL LOG

15-193-20074-00-00

OPERATOR: Thunderbird Drilling, Inc.  
 CONTRACTOR: Abercrombie Drilling, Inc.  
 WELL NAME: NIKL #1  
 LOCATION: SE SW Section 4-9S-35W  
 Thomas County, Kansas  
 SPUD DATE: March 7, 1976  
 COMPLETION DATE: March 20, 1976

0	110	Sand & clay
110	240	Sand
240	2078	Shale
2078	2822	Shale & Lime
2822	2854	Anhydrite
2854	3220	Lime & Shale
3220	3505	Shale & Lime
3505	3960	Lime & Shale
3960	4095	Lime
4095	4216	Lime & Shale
4216	4915	Lime (chert)
	4915	Rotary Total Depth

Drilled 260' of 12 1/4" hole. Ran 7 jts. used 8 5/8" - 28# steel casing, Set @ 245.27'. Tallied 247.92'. Cemented with 190 sx. 2% gel, 3% ca. cl. Allied cementing. Cement did circulate. Plug was down @ 5:30 a.m. March 7, 1976.

Plugged and Abandoned: 1st Plug was Set @ 1700' with 70 sx. cement; 2nd Plug was Set @ 250' with 20 sx. cement; 3rd Plug was Set @ 40' with 10 sx. cement. 50/50 Posmix, 6% gel. State Plugger: Gilbert Balthazor. Plug was down @ 9:30 a.m. March 20, 1976.

SAMPLE TOPS:

Anhydrite 2821'  
 B/Anhydrite 2854'

RECEIVED  
 STATE CORPORATION COMMISSION

MAR 25 1976

03-25-1976  
 CONSERVATION DIVISION  
 Wichita, Kansas

STATE OF KANSAS )  
 ) SS  
 COUNTY OF SEDGWICK )

Jerry A. Langrehr, Executive Vice President of Abercrombie Drilling, Inc., does hereby state that the above and foregoing is a true and correct copy of the log of the NIKL #1 SE SW Section 4-9S-35W, Thomas County, Kansas.

ABERCROMBIE DRILLING, INC.

By: Jerry A. Langrehr  
 Jerry A. Langrehr - Exec. Vice President

Subscribed and sworn to before me, a Notary Public, in and for the aforesaid county and state as of this 24th day of March, 1976.

Diane Steincamp  
 Diane Steincamp - Notary Public

My Commission Expires: February 18, 1980

