


Give All Information Completely
Make Required Affidavit
Mail or Deliver Report to:
Conservation Division
State Corporation Commission
211 No. Broadway
Wichita, Kansas

WELL PLUGGING RECORD

NORTH

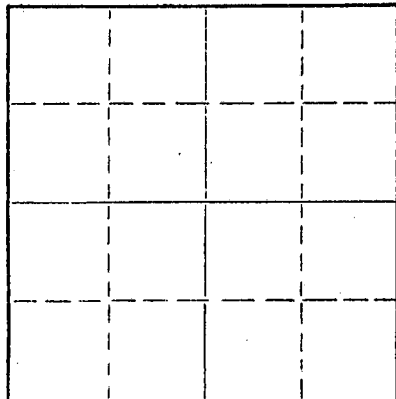

Locate well correctly on above Section Plat

Rocks _____ County. Sec. 1 Twp. 10 Rge. 16 (E) _____ (W) X
Location as "NE/CNW/SW" or footage from lines SW SW SW
Lease Owner Leo J. Dreiling
Lease Name Murphy Well No. 1
Office Address Victoria, Kansas
Character of Well (completed as Oil, Gas or Dry Hole) D. & A.
Date well completed 2/18/64 19
Application for plugging filed 2/18/64 19
Application for plugging approved 2/18/64 19
Plugging commenced 2/18/64 19
Plugging completed 2/18/64 19
Reason for abandonment of well or producing formation -0-

If a producing well is abandoned, date of last production -0- 19
Was permission obtained from the Conservation Division or its agents before plugging was commenced? Yes

Name of Conservation Agent who supervised plugging of this well Eldon Petty 3448'
Producing formation -0- Depth to top -0- Bottom -0- Total Depth of Well 3448' Feet
Show depth and thickness of all water, oil and gas formations.

OIL, GAS OR WATER RECORDS

CASING RECORD

FORMATION	CONTENT	FROM	TO	SIZE	PUT IN	PULLED OUT
Surface Pipe				8 5/8"	146'	-0-

Describe in detail the manner in which the well was plugged, indicating where the mud fluid was placed and the method or methods used in introducing it into the hole. If cement or other plugs were used, state the character of same and depth placed, from _____ feet to _____ feet for each plug set.

Filled hole with rotary mud to a depth of 180' were 1st plug was set using 20 sacks cement filling hole to a depth of 180' were 2nd plug was set using 20 sacks cement, filling hole with mud to a depth of 40' were 3rd plug was set using 10 sacks cement and filling hole to surface.


RECEIVED
STATE CORPORATION COMMISSION
MAR 4 1964
03-04-1964
CONSERVATION DIVISION
Wichita, Kansas

(If additional description is necessary, use BACK of this sheet)
Name of Plugging Contractor L. J. DREILING & SONS, INC.
Address VICTORIA, KANSAS

STATE OF KANSAS, COUNTY OF ELLIS, ss.
I, Leo F. Dreiling a partner of the above-described well, being first duly sworn on oath, says: That I have knowledge of the facts, statements, and matters herein contained and the log of the above-described well as filed and that the same are true and correct. So help me God.

(Signature) Leo F. Dreiling
LEO F. DREILING

(Address) _____, 19 64

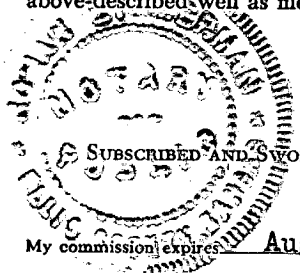

Edward Zimmerman
Notary Public.

My commission expires August 14, 1965

L. J. DREILING and SONS, Inc.

VICTORIA, KANSAS

15-163-02599-00-00
WELL LOG

Company Leo J. Dreiling Oil Company
Victoria, Kansas

Sec. 1 Twp. 10 Rng. 16

Farm Murphy No. 1

Location SW SW SW

Total Depth 3468

County Rooks County

Comm. 2/11/64 Comp. 2/18/64

Elevation: D. F. 1939'

Contractor L. J. DREILING & SONS, INC.
VICTORIA, KANSAS

G. R.

Casing Record

Cement Record

Production:

8 5/8" - - - 146'

100 sacks cement

D. & A.

Figures Indicate Bottom of Formations

0 - 50	Surface Clay
50 - 146	Clay & Shale
146 - 930	Shale & Sand
930 - 1110	Shale
1110 - 1143	Anhydrite
1143 - 1493	Shale
1493 - 1880	Shale & Lime
1880 - 2090	Lime
2090 - 2240	Lime
2240 - 2448	Shale
2448 - 2648	Shale
2648 - 2819	Shale & Shells
2819 - 2975	Shale & Lime
2975 - 3045	Lime
3045 - 3162	Lime
3162 - 3176	Lime
3176 - 3250	Lime
3250 - 3265	Lime
3265 - 3316	Lime
3316 - 3451	Lime
3451 - 3468	Lime
3468	TD

RECEIVED
STATE CORPORATION COMMISSION

MAR 4 1964
03-04-1964
CONSERVATION DIVISION
Wichita, Kansas

STATE OF KANSAS)
) ss.
COUNTY OF ELLIS)

I, Leo F. Dreiling, of the L. J. Dreiling & Sons, Inc., upon oath states that the above and foregoing is a true and correct copy from the Daily Drilling Report on your Murphy No. 1.

Leo F. Dreiling
LEO F. DREILING

Subscribed and sworn to before me this 2nd day of March, 1964.

Robert Zimmerman
NOTARY PUBLIC



My Commission Expires: August 14, 1965