


WELL PLUGGING RECORD

Give All Information Completely
Make Required Affidavit
Mail or Deliver Report to:
Conservation Division
State Corporation Commission
800 Bittling Building
Wichita, Kansas

Rooks County. Sec. 10 Twp. 10 Rge. 16 (E) W (W)
Location as "NE/CNW/SW" or footage from lines C S/2 SE/4 NE/4
Lease Owner Transit Corporation & Harold Krueger
Lease Name Welling Well No. 1
Office Address 1516 Liberty Bank Bldg., Oklahoma City, Okla.
Character of Well (completed as Oil, Gas or Dry Hole) Dry Hole
Date well completed June 4, 1953 19
Application for plugging filed June 4, 1953 19
Application for plugging approved June 4, 1953 19
Plugging commenced June 4, 1953 19
Plugging completed June 4, 1953 19
Reason for abandonment of well or producing formation _____

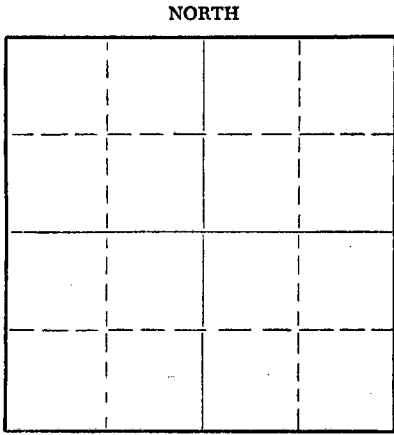

Locate well correctly on above
Section Plat

If a producing well is abandoned, date of last production _____ 19
Was permission obtained from the Conservation Division or its agents before plugging was commenced? Yes

Name of Conservation Agent who supervised plugging of this well Eldon Petty
Producing formation _____ Depth to top _____ Bottom _____ Total Depth of Well 3514 Feet
Show depth and thickness of all water, oil and gas formations.

OIL, GAS OR WATER RECORDS

CASING RECORD

FORMATION	CONTENT	FROM	TO	SIZE	PUT IN	PULLED OUT
				8-5/8	124'	None

Describe in detail the manner in which the well was plugged, indicating where the mud fluid was placed and the method or methods used in introducing it into the hole. If cement or other plugs were used, state the character of same and depth placed, from _____ feet to _____ feet for each plug set.

Filled hole with heavy drilling mud to 220' set plug and cemented with 15 sacks cement, filled hole with heavy drilling mud to 40' set plug and cemented to bottom of cellar with 10 sacks cement.

RECEIVED
STATE CORPORATION COMMISSION
JUN 13 1953
CONSERVATION DIVISION
WICHITA, KANSAS

(If additional description is necessary, use BACK of this sheet)
Name of Plugging Contractor Transit Corporation
Address 1516 Liberty Bank Bldg., Oklahoma City, Oklahoma

STATE OF Oklahoma, COUNTY OF Oklahoma, ss.
L. J. Kruse (employee of owner) or (~~owner or operator~~) of the above-described well, being first duly sworn on oath, says: That I have knowledge of the facts, statements, and matters herein contained and the log of the above-described well as filed and that the same are true and correct. So help me God.
(Signature) L. J. Kruse
Oklahoma City, Oklahoma (Address)

SUBSCRIBED AND SWORN TO before me this 10 day of June, 19 53

My commission expires Feb. 14, 1957


Evelyn C. Culler
Notary Public.

PLUGGING
FILE SEC 10 T 10 R 16W
BOOK PAGE 106 LINE 34

TRANSIT CORPORATION - KRUEGER

WELLING #1
E/2 NE/4 Section 10-10-16W
Rooks Co., Kansas

<u>FORMATION</u>	<u>FROM</u>	<u>TO</u>	
Shale	0	70	
Shale & Shells	70	124	- 7 Joints 8-5/8" CSA 124'.
Shale & Shells	124	490	Cemented with 75 sacks cement.
Sand & Shale	490	600	
Shale & Lime	600	650	
Sand & Shale	650	785	
Red Bed	785	932	
Shale & Shells	932	1080	
Anhydrite	1080	1115	
Shale & Shells	1115	1140	
Shells & Shale	1140	1240	
Shale	1240	1340	
Shale & Shells	1340	1441	
Shale & Shells	1441	2020	
Lime Shells & Shale	2020	2108	
Junk & Shale	2108	2131	
Shale	2131	2225	
Bro.Lime & Shale	2225	2305	
Lime & Shale	2305	2395	
Shale & Shells	2395	2470	
Shale & Bro. Sand	2470	2577	
Shale	2577	2780	
Lime & Shale	2780	2959	
Lime	2959	3312	
Shale & Lime	3312	3381	
Conglomerate & Chart	3381	3407	
Chert & Shale	3407	3454	
Cong. & Arf.	3454	3486	
Lime	3486	3500	
Lime	3500	3514	
 Total Depth		 3514	

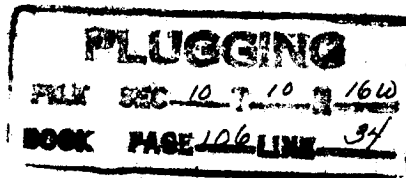

I hereby certify the foregoing to be a true and accurate Driller's Log of the formations encountered in the above well.

JUN 17 1953
 06-13-1953
 TRANSIT CORPORATION
 By: L. J. Kruse
 L. J. Kruse, President

Subscribed and sworn to before me this 12th day of June, 1953.

My commission expires Feb. 14, 1957

Notary Public