

15-163-21129-00-00

STATE OF KANSAS
STATE CORPORATION COMMISSION

WELL PLUGGING RECORD

Give All Information Completely
Make Required Affidavit
Mail or Deliver Report to
Conservation Division
State Corporation Comm.
245 North Water
Wichita, KS 67202

Rooks County, Sec. 12 Twp. 10S Rge. 16 NE/W
Location as "NE/CNW/SW" or footage from lines
SW SE NW

Lease Owner Liberty Enterprises, Inc.
Lease Name Hachmeister Well No. #1

Office Address 308 West Mill Plainville, Kansas 67663
Character of Well (Completed as Oil, Gas or Dry Hole)


Dry Hole

Date Well completed August 5 1980
Application for plugging filed August 5 1980
Application for plugging approved August 5 1980
Plugging commenced August 5 1980
Plugging completed August 5 1980
Reason for abandonment of well or producing formation
No commercial production

If a producing well is abandoned, date of last production 19

Was permission obtained from the Conservation Division or
its agents before plugging was commenced? yes

Name of Conservation Agent who supervised plugging of this well Marion Schmidt
Producing formation Depth to top Bottom Total Depth of Well 3550
Show depth and thickness of all water, oil and gas formations.

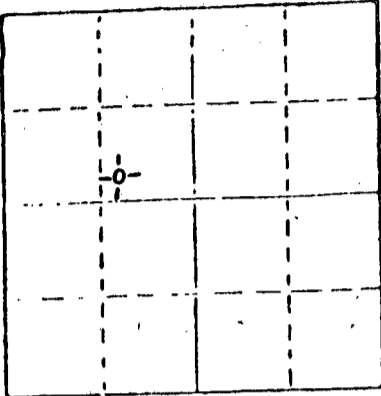

Locate well correctly on above Section Plot

OIL, GAS OR WATER RECORDS

CASING RECORD

FORMATION	CONTENT	FROM	TO	SIZE	PUT IN	PULLED OUT
surface casing	common	0	280.25'	8 5/8"	280.25'	0

Describe in detail the manner in which the well was plugged, indicating where the mud fluid was placed and the method or methods used in introducing it into the hold. If cement or other plugs were used, state the character of same and depth placed, from feet to feet for each plug set.

- Plug #1 @ 600' with 70 sx
- Plug #2 @ 270' with 25 sx
- Plug #3 @ 40' with sx of hulls wooden plug & 10 sx
- Plugged rathole with 5 sx
- Plugdown @ 7:45 p.m.

RECEIVED
STATE CORPORATION COMMISSION
08-14-1980
AUG 14 1980

(If additional description is necessary, use BACK of this sheet)

Name of Plugging Contractor Pioneer Drilling Company, Inc.
308 West Mill Plainville, Kansas 67663
CONSERVATION DIVISION
Wichita, Kansas

STATE OF Kansas COUNTY OF Rooks, ss.
Roger L. Comeau (employee of owner) or (owner or operator)


of the above-described well, being first duly sworn on oath, says: That I have knowledge of the facts, statements, and matters herein contained and the log of the above-described well as filed and that the same are true and correct. So help me God.

(Signature) Roger L. Comeau
August 12, 1980
(Address)

SUBSCRIBED AND SWORN TO before me this 12th day of August, 1980

Connie Jo Austin
Notary Public.

My commission expires

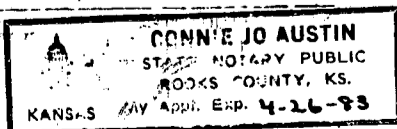

15-163-21129-00-00

WELL LOG

OPERATOR: Liberty Enterprises, Inc.

WELL NAME: Hachmeister #1 LOCATION: SW SE NW 12-10S-16W

COUNTY: Rooks STATE: Kansas

WELL COMMENCED: July 28, 1980 WELL COMPLETED: August 5, 1980

ELEVATION: 1905' K. B. TOTAL DEPTH: 3550'

PRODUCTION: D & A RIG NO: #1

CASING - 8-5/8": 280.25' of new 20# cemented with 140 sxs common 3% cc 2% gel cement circ
5-1/2": _____

ALL MEASUREMENTS TAKEN FROM THE TOP OF ROTARY BUSHING:

FROM	TO	FORMATION	DEVIATION FROM VERTICAL	REMARKS:
0'	287'			
287'	1034'	sand and shale		
1034'	1081'	shale and redbed		
1081'	1116'	Anhydrite		
1116'	1490'	shale and shells		
1490'	1659'	shale and shells		
1659'	1870'	lime and shale	1659' - 1 1/4 degree	
1870'	2101'	lime and shale		
2101'	2371'	lime and shale		
2371'	2605'	lime and shale		
2605'	2790'	lime and shale		
2790'	2862'	lime and shale		
2862'	2977'	lime and shale		
2977'	3057'	lime and shale		
3057'	3063'	lime and shale		
3063'	3136'	lime and shale		
3136'	3158'	lime and shale	3158' - 1 degree	
3158'	3219'	lime and shale		
3219'	3260'	lime and shale		
3260'	3319'	lime and shale		
3319'	3355'	shale and lime		
3355'	3420'	shale and lime		
3420'	3468'	shale and lime		
3468'	3550'	lime and shale		
3550'	RTD			

RECEIVED
STATE CORPORATION COMMISSION
AUG 14 1980
08-14-1980
CONSERVATION DIVISION
Wichita, Kansas

STATE OF KANSAS
COUNTY OF _____

The undersigned hereby certifies that to the best of his knowledge and belief, the above facts are true and correct

PIONEER DRILLING CO., INC.

By Reginald A. Corwin

SUBSCRIBED AND SWORN TO, BEFORE ME, This 12th day of Aug., 1980.

Connie Jo Austin
NOTARY PUBLIC

