

15-163-20660-00-00


STATE OF KANSAS
STATE CORPORATION COMMISSION

WELL PLUGGING RECORD

Give All Information Completely
Make Required Affidavit
Mail or Deliver Report to
Conservation Division
State Corporation Comm.
245 North Water
Wichita, KS 67202

Rooks County, Sec. 17 Twp. 10 Rge. 16W E/W
Location as "NE/CNW $\frac{1}{4}$ SW $\frac{1}{4}$ " or footage from lines
SW-SW-NW

Lease Owner PICKRELL DRILLING COMPANY
Lease Name Dougherty "A" Well No. 1
Office Address 205 LITWIN BLDG., WICHITA, KS. 67202
Character of Well (Completed as Oil, Gas or Dry Hole) Dry Hole
Date Well completed 11-28-76 19
Application for plugging filed 11-28-76 19
Application for plugging approved 11-28-76 19
Plugging commenced 11-28-76 19
Plugging completed 11-28-76 19
Reason for abandonment of well or producing formation Dry Hole

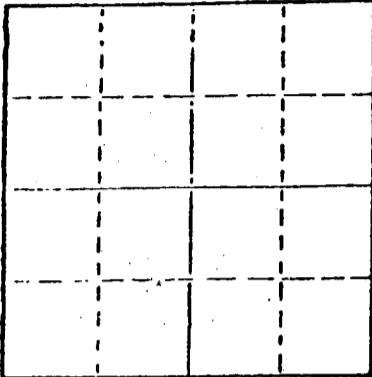

Locate well correctly on above
Section Plat

If a producing well is abandoned, date of last production 19

Was permission obtained from the Conservation Division or
its agents before plugging was commenced? Yes

Name of Conservation Agent who supervised plugging of this well Leo Massey
Producing formation _____ Depth to top _____ Bottom _____ Total Depth of Well 3635
Show depth and thickness of all water, oil and gas formations.

OIL, GAS OR WATER RECORDS

CASING RECORD

FORMATION	CONTENT	FROM	TO	SIZE	PUT IN	PULLED OUT
				8 5/8	205	None

Describe in detail the manner in which the well was plugged, indicating where the mud fluid
was placed and the method or methods used in introducing it into the hold. If cement or other
plugs were used, state the character of same and depth placed, from _____ feet to
_____ feet for each plug set.

70 sacks at 660'
20 sacks at 185'
10 sacks at 40' Job comp. 10AM 11/28/76

STATE CORPORATION COMMISSION

DEC 15 1976

12-15-1976

CONSERVATION DIVISION
Wichita, Kansas

(If additional description is necessary, use BACK of this sheet)

Name of Plugging Contractor Pickrell Drilling Company

STATE OF Kansas COUNTY OF Sedgwick, ss.
C. W. Sebitts (employee of owner) or (owner or operator)

of the above-described well, being first duly sworn on oath, says: That I have knowledge of
the facts, statements, and matters herein contained and the log of the above-described well
as filed and that the same are true and correct. So help me God

(Signature)

205 Litwin Bldg. Wichita, Ks. 67202

(Address)

SUBSCRIBED AND SWORN TO before me this 6 day of December, 1976

Jo Ann Sarver
Notary Public.

Notary Public.

Jo Ann Sarver

My commission expires _____



ROTARY DRILLING LOG

COMPANY: PICKRELL DRILLING COMPANY
205 LITWIN BLDG.
WICHITA, KS. 67202
LOCATION: Dougherty "A" #1
SW SW NW 17-10-16
Rooks Co., Ks.

Rotary Drilling Commenced 11-20-76

Rotary Drilling Completed 11-28-76

CONTRACTOR: **PICKRELL DRILLING COMPANY**
Wichita, Kansas

CASING RECORD: Set surface casing of 8 5/8" @ 205' with 150 sacks. Comp. 11:30PM 11-20

LOG

(Figures indicate bottom of formation — measurements from top of rotary bushing.)

Post Rock	75
Shale	215
Shale & Sand	990
Shale & Lime	1266
Shale & Lime	1306
Shale & Lime	1405
Shale	1705
Shale & Lime	2035
Shale & Lime	2210
Lime	2395
Lime & Shale	2565
Lime & Shale	2645
Lime & Shale	2810
Lime & Shale	2916
Lime & Shale	3010
Lime	3100
Lime	3160
Lime	3232
Lime	3307
Lime	3370
Lime	3440
Lime	3505
Lime	3570
Lime	3603
Lime	3635

RECEIVED
STATE CONSERVATION COMMISSION
DEC 15 1976
12-15-1976
CONSERVATION DIVISION
Wichita, Kansas

The undersigned, C. W. Sebitts, Attorney-in-Fact for PICKRELL DRILLING COMPANY, hereby certifies in behalf of said Company, that the above is a true and correct log of the formation encountered in drilling the above well as reflected by the Daily Drilling Reports.

PICKRELL DRILLING COMPANY
By [Signature]
C. W. Sebitts Attorney-in-Fact

STATE OF KANSAS }
COUNTY OF SEDGWICK } ss.:

On this 6 day of December, 19 76, before me the undersigned, a Notary Public, in and for

the County and State aforesaid, personally appeared C. W. Sebitts, to me known to be the identical person who subscribed the name of PICKRELL DRILLING COMPANY to the foregoing instrument as its Attorney-in-Fact and acknowledged to me that he executed the same as his free and voluntary act and deed, and as the free and voluntary act and deed of such company, for the uses and purposes therein set forth.

Given under my hand and seal of office the day and year last above written.

My commission expires:

[Signature]
Jo Ann Sarver
Notary Public

