

KCC
MUL
7/17/08

KANSAS CORPORATION COMMISSION
OIL & GAS CONSERVATION DIVISION
WELL PLUGGING APPLICATION
Please TYPE Form and File ONE Copy

Form CP-1
September 2003
This Form must be Typed
Form must be Signed
All blanks must be Filled

API # 15 - 095-00810-0000 (Identifier Number of this well). This must be listed for wells drilled since 1967; if no API # was issued,

indicate original spud or completion date Spud June 5, 1962

Well Operator: Pickrell Drilling Company, Inc. KCC License #: 5123
(Owner / Company Name) (Operator's)

Address: 100 S. Main, Suite 505 City: Wichita

State: Kansas Zip Code: 67202 Contact Phone: (316) 262-8427

Lease: {Swingle "A"} Well #: 3 Sec. 36 Twp. 30S S. R. 9 East West

C - SE - SW - NW Spot Location / QQQQ County: Kingman

2970 Feet (in exact footage) From North / South (from nearest outside section corner) Line of Section (Not Lease Line)

4290 Feet (in exact footage) From East / West (from nearest outside section corner) Line of Section (Not Lease Line)

Check One: Oil Well Gas Well D&A Cathodic Water Supply Well
 SWD Docket # _____ ENHR Docket # _____ Other: _____

Conductor Casing Size: _____ Set at: _____ Cemented with: _____ Sacks

Surface Casing Size: 8 5/8 Set at: 249 Cemented with: 165 Sacks

Production Casing Size: 4 1/2 Set at: 4448 Cemented with: 110 (Estimated)* Sacks

List (ALL) Perforations and Bridgeplug Sets: Abrasijet Notch at 4404 **SEE ALSO WELL SKETCH ATTACHED**

* Estimate based on area and common usage at that time.

Elevation: 1637 (G.L. / K.B.) T.D.: 4449 PBTD: 4417 Anhydrite Depth: Heebner 3417 (-1775)
(Stone Gonal Formation)

Condition of Well: Good Poor Casing Leak Junk in Hole

Proposed Method of Plugging (attach a separate page if additional space is needed): Plug back w/ sand to 4350. Use dump bailer to spot 5 sx. of cement on top of sand. Cut and recover 4 1/2" casing. Spot cement plugs thru 4 1/2" casing as POOH as requested by K.C.C. representative.

RECEIVED
KANSAS CORPORATION COMMISSION

Is Well Log attached to this application as required? Yes No Is ACO-1 filed? Yes No

JUL 17 2008

CONSERVATION DIVISION
WICHITA, KS

Plugging of this Well will be done in accordance with K.S.A. 55-101 et. seq. and the Rules and Regulations of the State Corporation Commission.

List Name of Company Representative authorized to be in charge of plugging operations: Deon Howard

Phone: (620) 793-2316

Address: 2485 S. State Rd. 14 City / State: Kingman, Kansas 67068-8629

Plugging Contractor: Quality Well Service KCC License #: 31925
(Company Name) (Contractor's)

Address: 190 US Highway 56, Ellinwood, KS 67526 Phone: (620) 727-3410

Proposed Date and Hour of Plugging (if known?): When rig becomes available

Payment of the Plugging Fee (K.A.R. 82-3-118) will be guaranteed by Operator or Agent
Date: 07-16-08 Authorized Operator / Agent: [Signature]
Signature


Mail to: KCC - Conservation Division, 130 S. Market - Room 2078, Wichita, Kansas 67202

BAKER SERVICE TOOLS - TALLY PAD

New Completion Workover

Oil Company _____ Well No. 3 Field Spivey Lease Swingle "A"
Company Man _____ Date Drilled June 1962 County Kingman State Kansas

C J E SW NW Sec 36-305-9W
API# 15-095-00810

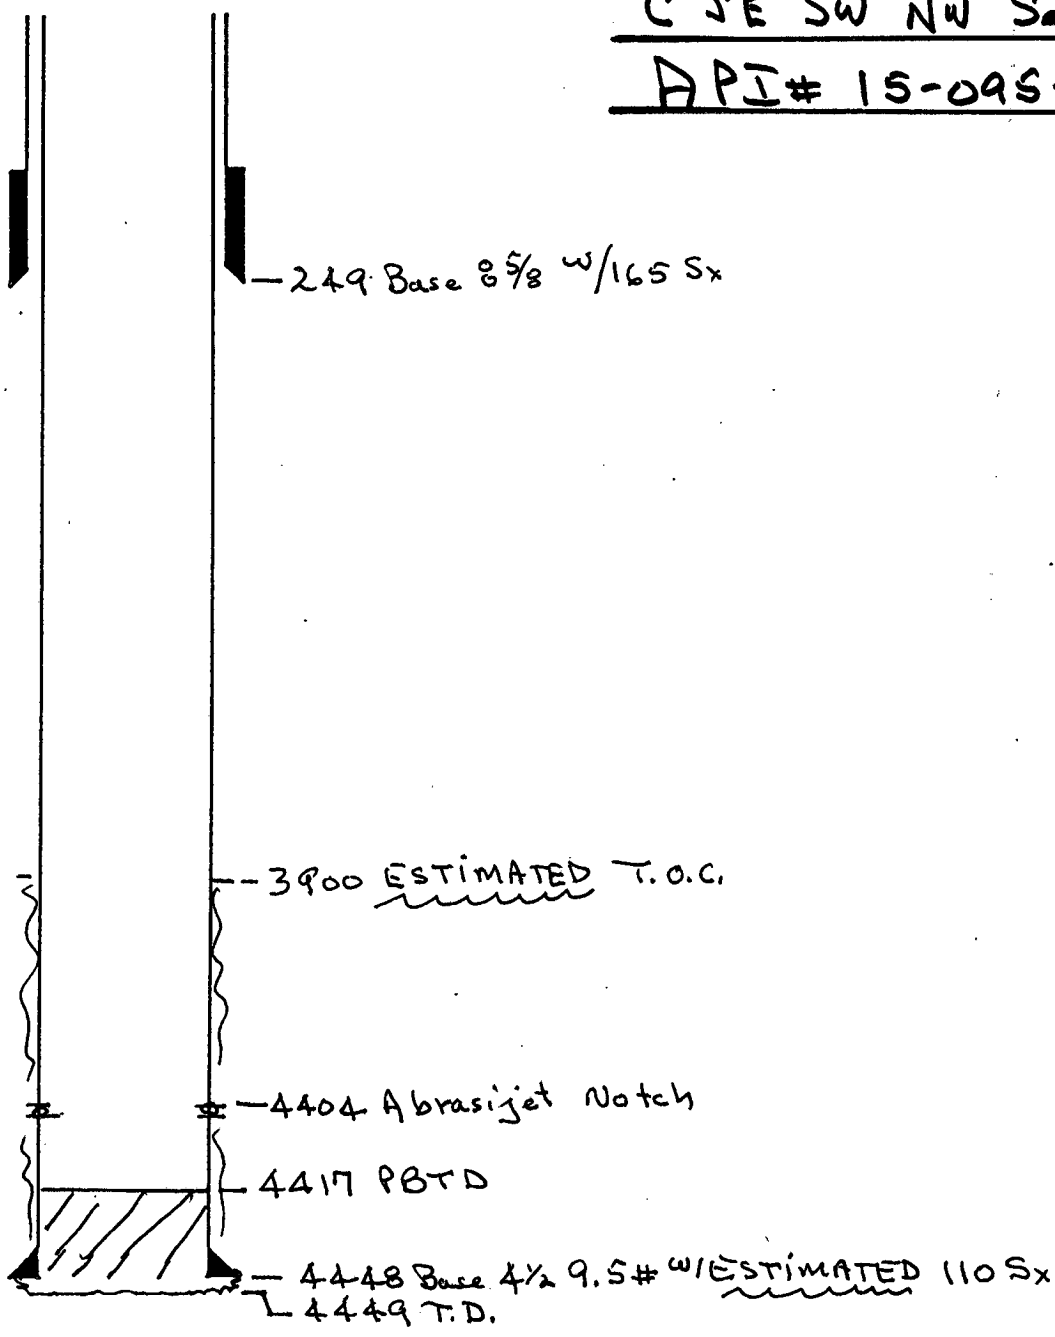

RECEIVED
KANSAS CORPORATION COMMISSION

JUL 17 2008

CONSERVATION DIVISION
WICHITA, KS

REMARKS: _____

Date of Tally _____
No. Jts. on Location _____
Tbg. Sz. _____ Thd. _____ Wt. _____ Gr. _____
Csg. Sz. _____ Wt. _____ Gr. _____



KANSAS

CORPORATION COMMISSION

Kathleen Sebelius, Governor Thomas E. Wright, Chairman Michael C. Moffet, Commissioner Joseph F. Harkins, Commissioner

NOTICE OF RECEIPT OF WELL PLUGGING APPLICATION (CP-1)

PICKRELL DRILLING COMPANY, INC.
100 S MAIN STE 505
WICHITA, KS 67202-3738

July 21, 2008

Re: SWINGLE "A" #3
API 15-095-00810-00-00
36-30S-9W, 2970 FSL 4290 FEL
KINGMAN COUNTY, KANSAS


Dear Operator:

This letter is to notify you that the Conservation Division has received your plugging proposal, form CP-1, for the above well and has reviewed the proposal for completeness. The central office will now forward your CP-1 to the district office listed below for review of the proposed plugging method. **Please contact the district office for approval of your proposed plugging method at least five (5) days before plugging the well, pursuant to K.A.R. 82-3-113(b). If a workover pit will be used during the plugging of the well it must be permitted. A CDP-1 form must be filed and approved prior to the use of the pit in accordance with K.A.R. 82-3-600.**

The Conservation Division's review of form CP-1, either in the central or district office, does not include an inquiry into well ownership or the filing operator's legal right to plug the well. This notice in no way constitutes authorization to plug the above well by persons not having legal rights of ownership or interest in the well.

This notice is void after January 17, 2009. The CP-1 filing does not bring the above well into compliance with K.A.R. 82-3-111 with regard to the Commission's temporary abandonment requirements.

Sincerely,

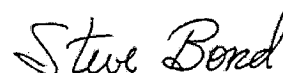

Steve Bond
Production Department Supervisor

District: #2
3450 N. Rock Road, Suite 601
Wichita, KS 67226
(316) 630-4000