


15-065-0111-00-00

STATE OF KANSAS
STATE CORPORATION COMMISSION

WELL PLUGGING RECORD

Give All Information Completely
Make Required Affidavit
Mail or Deliver Report to:
Conservation Division
State Corporation Commission
800 Biting Building
Wichita, Kansas

Location as Graham County, Sec. 35 Twp. 9S Rge. 22 (2) W (W)
Lease Owner Don W. Jones
Lease Name Coltison Well No. 1
Office Address 1708 Philtower Bldg., Tulsa, Oklahoma
Character of Well (completed as Oil, Gas or Dry Hole) Dry hole
Date well completed Sent. 26 1952
Application for plugging filed Sent. 26 1952
Application for plugging approved Sent. 26 1952
Plugging commenced Sent. 26 1952
Plugging completed Sent. 26 1952
Reason for abandonment of well or producing formation Dry hole

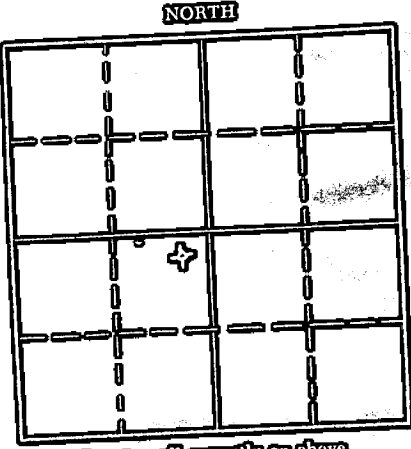

If a producing well is abandoned, date of last production 19
Was permission obtained from the Conservation Division or its agents before plugging was commenced? yes
Name of Conservation Agent who supervised plugging of this well Eldon Perry

Producing formation _____ Depth to top _____ Bottom _____ Total Depth of Well 3985 Feet
Show depth and thickness of all water, oil and gas formations.

OIL, GAS OR WATER RECORDS

CASING RECORD

FORMATION	CONTENT	FROM	TO	SIZE	PUT IN	PULLED OUT
		0	192	3 5/8	192	None

Describe in detail the manner in which the well was plugged, indicating where the mud fluid was placed and the method or methods used in introducing it into the hole. If cement or other plugs were used, state the character of same and depth placed, from _____ feet to _____ feet for each plug set.

From 3985' to 1865' - heavy rotary mud
1865' to 1850' - wooden plug
1850' to 1390' - 15 sacks cement and 1/2 sack hulls
1390' to 1150' - heavy rotary mud
1150' to 100' - wooden plug
100' to 60' - 10 sacks cement and 1/2 sack hulls
60' to surface - cellular

(If additional description is necessary, use BACK of this sheet)

Name of Plugging Contractor Glenn W. Peel
Address P.O. Box 359, Holsington, Kansas

STATE OF KANSAS COUNTY OF BARTON, ss.
Glenn W. Peel (employee of owner) or (owner or operator) of the above-described

well, being first duly sworn on oath, says: That I have knowledge of the facts, statements, and matters herein contained and the log of the above-described well as filed and that the same are true and correct. So help me God. GLENN W. PEEL
(Signature) _____ BY: [Signature]

P.O. Box 359, Holsington, Kansas
(Address)



Subscribed and sworn to before me this 27th day of September, 1952
[Signature]
Notary Public

DRILLER'S LOG

Company: Don W. Jones

NE NE SW

Farm Name: Collison Well No. 1

Sec. 35, Twp. 9S, Rge. 22W,

Depth: 3985'

County: Graham,
Kansas

Comm: 9-17-53 Comp: 9-26-53

Elevation:

Contractor: Glenn W. Peel

Production: Dry

Casing: 8 5/8 - 192' cem.

Figures below indicate bottoms of formations:

Sand and Shells	0 -	145
Blue Shale		880
Shale		1820
Anhydrite		1855
Shale and Shells		1925
Shale		2215
Shale and Lime		2360
Limed shale		2525
Lime		2800
Limed shale		2975
Lime		3985
Total Depth		3985

This is to certify that the above information is to the best of our knowledge, true and correct.

GLENN W. PEEL

BY: W. Herbert

SUBSCRIBED AND SWORN to before me this 28th day of September, 1953.

My commission expires: June 4, 1955

Marion M. Herbert
Notary Public

