

STATE OF KANSAS
STATE CORPORATION COMMISSION

WELL PLUGGING RECORD

Give All Information Completely
Make Required Affidavit
Mail or Deliver Report to:
Conservation Division
State Corporation Commission
800 Bittling Building
Wichita, Kansas

Graham

County, Sec. 35 Twp. 9S Rge. 22 (E) W (W)

Location as "NE/CNW $\frac{1}{4}$ SW $\frac{1}{4}$ " or footage from lines NE/4 NE/4 NE/4

Lease Owner Peel-Hardman

Lease Name Wilson Well No. 1

Office Address P. O. Box 359, Hoisington, Kansas

Character of Well (completed as Oil, Gas or Dry Hole) Dry Hole

Date well completed September 7 19 51

Application for plugging filed " 7 19 51

Application for plugging approved " 7 19 51


Plugging commenced " 7 19 51

Plugging completed " 7 19 51

Reason for abandonment of well or producing formation Dry Hole

If a producing well is abandoned, date of last production 19

Was permission obtained from the Conservation Division or its agents before plugging was commenced? We Yes

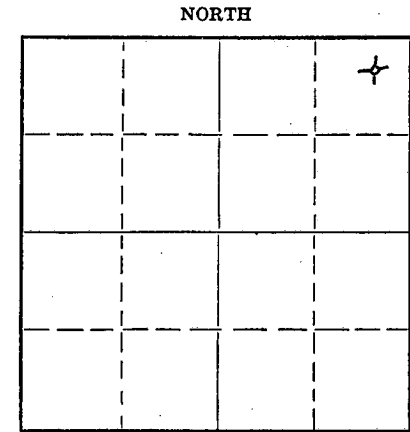

Locate well correctly on above Section Flat

Name of Conservation Agent who supervised plugging of this well E. R. Petty

Producing formation Depth to top Bottom Total Depth of Well 3984 Feet

Show depth and thickness of all water, oil and gas formations.

OIL, GAS OR WATER RECORDS

CASING RECORD

Formation	Content	From	To	Size	Put In	Pulled Out
		0	185'	8 5/8"	185'	None

Describe in detail the manner in which the well was plugged, indicating where the mud fluid was placed and the method or methods used in introducing it into the hole. If cement or other plugs were used, state the character of same and depth placed, from feet to feet for each plug set.

- 3984' - 181 $\frac{1}{2}$ ' - Heavy Rotary Mud
- 181 $\frac{1}{2}$ ' - 180' - Wooden Plug
- 180' - 134' - 15 sacks cement
- 134' - 41 $\frac{1}{2}$ ' - Heavy Rotary Mud
- 41 $\frac{1}{2}$ ' - 40' - Wooden Plug
- 40' - 6' - 10 sacks cement
- 6' - Surface - Cellar

6/19/51
SEP 19 1951
CN

(If additional description is necessary, use BACK of this sheet)

Name of Plugging Contractor Peel-Hardman

Address P. O. Box 359, Hoisington, Kansas

STATE OF Kansas, COUNTY OF Barton, ss.

Peel-Hardman (employee of owner) or (owner or operator) of the above-described well, being first duly sworn on oath, says: That I have knowledge of the facts, statements, and matters herein contained and the log of the above-described well as filed and that the same are true and correct. So help me God. PEEL-HARDMAN

(Signature) BY: [Signature] P. O. Box 359, HOISINGTON, KANSAS

(Address)

SUBSCRIBED AND SWORN TO before me this 18th day of September, 1951

[Signature] Notary Public.

My commission expires June 4, 1955

PLUGGING
FILE SEC 35 T 9 R 22
BOOK PAGE 108 LINE 29

DRILLER'S LOG

Company: Peel-Hardman

NE/4 NE/4 NE/4
Sec. 35, Twp. 9S, Rge. 22W

Farm: Wilson Well No. 1

Total Depth: 3984'

County: Graham, Kansas

Comm: 8-28-51 Comp. 9-7-51

Contractor: Peel-Hardman

Elevation:

Casing:

8 5/8" 185' cem.

Production: Dry

Figures below indicate bottom of formations

Sand, Shale & Shells	0 -	190
Shale		825
Sand & Shale		1520
Shale & Shells		1800
Shale & Lime		1845
Anhydrite		1880
Shale & Shells		2750
Shale & Lime		2820
Shale & Shells		2950
Shale		3035
Shells & Shale		3225
Shale, Shells & Lime		3345
Lime & Shale		3585
Lime		3885
Conglomerate		3925
Lime		3984
Total Depth		3984

This is to certify that the above information is to the best of my knowledge true and correct.

PEEL-HARDMAN

BY: Wm Herbert

SUBSCRIBED AND SWORN to before me this 18th day of September, 1951.

My commission expires June 4, 1955 Marian M. Herbert



PLUGGING
FILE SEC 35 T 9 R 22W
BOOK PAGE 108 LINE 29

RECEIVED
SEP 19 1951