


15-173-00975-00-01

STATE OF KANSAS
STATE CORPORATION COMMISSION

WELL PLUGGING RECORD

Give All Information Completely
Take Required Affidavit
Mail or Deliver Report to
Conservation Division
State Corporation Comm.
245 North Water
Wichita, KS 67202

SEDGWICK County. Sec. 8 Twp. 26S Rge. 2E/W
Location as "NE/CNW/SW" or footage from lines
CWL SW NE 660 FSL 330 FWL
Lease Owner WILEY ASH JR
Lease Name MEYERS OWWO Well No. #1
Office Address 260 N. ROCK RD. WICHITA, KS
Character of Well (Completed as Oil, Gas or Dry Hole)

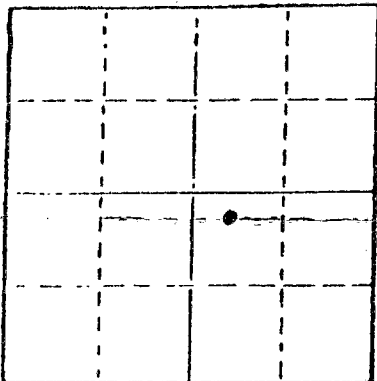

Locate well correctly on above
Section Plot

Date Well completed 2-20 1980
Application for plugging filed 2-20 1980
Application for plugging approved 2-20 1980
Plugging commenced 2-20 1980
Plugging completed 2-20 1980
Reason for abandonment of well or producing formation

DRY HOLE
If a producing well is abandoned, date of last production
19 80

Was permission obtained from the Conservation Division or
its agents before plugging was commenced? YES

Name of Conservation Agent who supervised plugging of this well CARL BARNETT
Producing formation _____ Depth to top _____ Bottom _____ Total Depth of Well 3500
Show depth and thickness of all water, oil and gas formations.

OIL, GAS OR WATER RECORDS

CASING RECORD

FORMATION	CONTENT	FROM	TO	SIZE	PUT IN	PULLED OUT
		0	103	8 5/8	103	none

Describe in detail the manner in which the well was plugged, indicating where the mud fluid
was placed and the method or methods used in introducing it into the hold. If cement or other
plugs were used, state the character of same and depth placed, from _____ feet to
_____ feet for each plug set.

MUD TO 220' PLUG 30 SKS CEMENT

MUD TO 40' PLUG 10 SKS CEMENT

3 SACKS CEMENT FOR RAT HOLE

(If additional description is necessary, use BACK of this sheet)


Name of Plugging Contractor BLUE STREAK DRILLING INC.

STATE OF KANSAS COUNTY OF COWLEY, ss.

(employee of owner) or (owner or operator)
of the above-described well, being first duly sworn on oath, says: That I have knowledge of
the facts, statements, and matters herein contained and the log of the above-described well
as filed and that the same are true and correct. So help me God.

(Signature) Jans Larson
1027 Highland Drive Ark. City, KS
(Address)

SUBSCRIBED AND SWORN TO before me this 24 day of Feb, 19 80

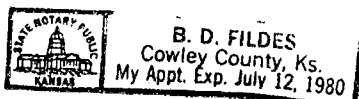

B D Fildes
Notary Public.

My commission expires _____

RECEIVED
STATE CORPORATION COMMISSION

MAR - 6 1980
3-6-80
CONSERVATION DIVISION
Wichita, Kansas

DRILLERS LOG

CASING RECORD:
103' 8 ⁵/₈

COMPANY: WILEY ASH JR. DESCRIPTION:
CONTRACTOR: BLUE STREAK DRILLING, MEYERS OWWO
COMMENCED: 2-12-80
COMPLETED: 2-20-80

TOTAL DEPTH:
3500

ELEVATION:

<u>FORMATION</u>	<u>FROM</u>	<u>TO</u>	<u>REMARKS</u>
Miss	3000	3150	Lime
Kinderhook	3400	3450	SHALE
SIMPSON	3450	3500	SANDY DOLOMITE

I certify that this is a true and correct copy of the above log to the best of my knowledge.

BLUE STREAK DRILLING INC

Lars Larson

Subscribed and sworn to before me this 24 day of Feb, 1979⁸⁰

B. D. Felder
Notary Public

My Commission Expires:



RECEIVED
STATE CORPORATION COMMISSION

MAR - 6 1980

CONSERVATION DIVISION
Wichita, Kansas