

15-173-02013-00-00


STATE OF KANSAS
STATE CORPORATION COMMISSION

Give All Information Completely
Make Required Affidavit
Mail or Deliver Report to:
Conservation Division
State Corporation Commission
800 Bitting Building
Wichita, Kansas

WELL PLUGGING RECORD

Sedgwick County. Sec. 8 Twp. 26S Rge. 2 (E) (W)
Location as "NE/CNW/SW" or footage from lines Cen. N/2 NW/4 NW/4

Lease Owner John P. Gaty
Lease Name Timmerkamp Well No. 1
Office Address 11 Cypress Dr., Wichita, Kansas
Character of Well (completed as Oil, Gas or Dry Hole) Oil
Date well completed March 5 1949
Application for plugging filed July 6 1953
Application for plugging approved July 7 1953
Plugging commenced July 8 1953
Plugging completed July 14 1953
Reason for abandonment of well or producing formation Water

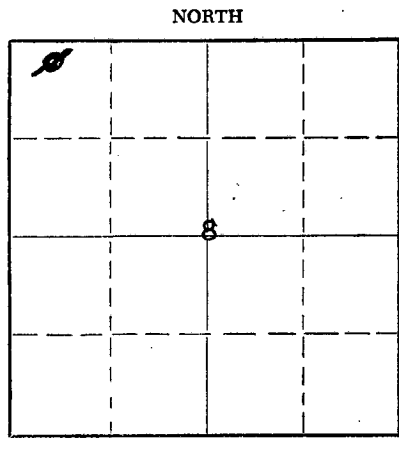

Locate well correctly on above Section Plat

If a producing well is abandoned, date of last production July 18 1952
Was permission obtained from the Conservation Division or its agents before plugging was commenced? Yes

Name of Conservation Agent who supervised plugging of this well Mr. Ruel Durkee
Producing formation _____ Depth to top _____ Bottom _____ Total Depth of Well 3021 Feet
Show depth and thickness of all water, oil and gas formations.

OIL, GAS OR WATER RECORDS

CASING RECORD

FORMATION	CONTENT	FROM	TO	SIZE	PUT IN	PULLED OUT

Describe in detail the manner in which the well was plugged, indicating where the mud fluid was placed and the method or methods used in introducing it into the hole. If cement or other plugs were used, state the character of same and depth placed, from _____ feet to _____ feet for each plug set.


Plugged back 3021' to 2995' with sand and 6 sacks cement
3 yards heavy mud
Mudded with light mud to 110'
20' rock bridge with 15 sacks cement at 110'
Heavy mud to 20'
Rick bridge with 5 sacks cement.

(If additional description is necessary, use BACK of this sheet)
Name of Plugging Contractor John P. Gaty
Address 11 Cypress Dr., Wichita, Kansas

STATE OF Kansas, COUNTY OF Sedgwick, ss.
Earl Wentworth (employee of owner) ~~or (owner or operator)~~ of the above-described well, being first duly sworn on oath, says: That I have knowledge of the facts, statements, and matters herein contained and the log of the above-described well as filed and that the same are true and correct. So help me God.

(Signature) Earl Wentworth
Mulvane, Kansas (Address)

SUBSCRIBED AND SWORN to before me this 20th day of July, 1953
My commission expires December 12, 1955

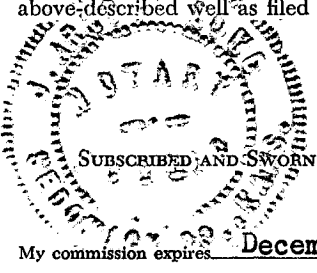

J. Arnold Sewal
RECEIVED
STATE CORPORATION COMMISSION

PLUGGING
FILE SEC 8 T 26 R 2E
BOOK PAGE 112 LINK 41

JUL 22 1953
7-22-53
CONSERVATION DIVISION
Wichita, Kansas


Company: John P. Gaty
 Farm: Timmerkamp #1

Comm: January 11, 1949
 Comp: March 5, 1949
 Contractor: Max Howell

Section 8, T 26 S, R 2 E
 Cen. NL NW NW
 Sedgwick County, Kansas
 Cable Tools
 Elevation: 1451' D. F.
 Total Depth: 3021
 Initial Potential:

Casing: 12-1/2" @ 980'
 10" @ 1635'
 8" @ 2606'
 7" @ 3004'

0-8	Cellar	1035-1040	Lime
30	Yellow clay	1065	Shale
55	Shale	1070	Lime
60	Red Rock	1095	Shale
135	Shale	1100	Lime
145	Sandy shale	1105	Red rock
170	Shale	1110	Lime
185	Lime	1120	Shale
225	Shale	1125	Lime
230	Lime	1150	Shale
240	Shale	1155	Lime
260	Lime	1175	Shale
270	Shale	1180	Red rock
295	Lime	1200	Shale sandy
320	Shale	1205	Lime
345	Lime	1230	Shale
365	Red rock	1235	Lime
375	Lime	1265	Shale
395	Shale	1280	Lime
415	Lime	1285	Shale
420	Shale	1295	Lime
425	Red rock	1330	Shale
440	Shale	1340	Lime white, hard
520	Lime	1355	Lime
525	Shale	1360	Shale
530	Lime	1370	Lime shells
540	Shale	1375	Lime
550	Lime	1405	Shale & lime
560	Shale	1420	Lime
590	Lime	1435	Shale
610	Shale	1440	Lime
685	Lime	1455	Shale
695	Shale	1460	Lime
700	Red rock	1515	Shale
710	Lime	1525	Lime
720	Shale	1530	Shale
725	Lime	1570	Lime
730	Shale	1575	Shale
740	Lime	1580	Lime
750	Shale	1610	Shale
785	Shale & lime	1632	Sandy shale
790	Shale & shells	1645	Shale
800	Lime	1685	Lime
825	Shale	1720	Shale
840	Lime	1740	Lime
880	Shale & lime	1745	Sandy lime
890	Lime	1750	Lime
895	Shale	1755	Black shale
905	Lime	1760	Lime
910	Shale	1765	Shale
920	Lime	1780	Lime
930	Shale	1805	Shale
940	Sandy shale	1820	Lime
995	Lime	1830	Shale
1010	Shale	1850	lime
1020	Lime, hard	1855	Shale
1035	Shale	1895	Lime

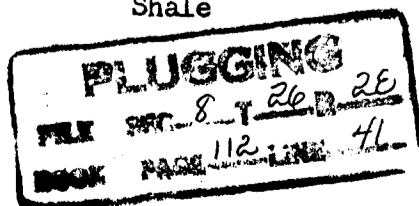

RECEIVED
 STATE CORPORATION COMMISSION

JUL 7 1949

CONSERVATION DIVISION
 WORKS, ...

#1 Timmerkamp -

1895-1900	Shale
1935	Lime
1940	Sandy lime
1950	Lime
1955	Shale
1990	Lime
1995	Shale
2000	Lime
2010	Shale
2030	Lime
2045	Shale
2055	Lime
2190	Shale
2200	Lime
2225	Shale
2245	Lime
2340	Shale
2405	Lime
2410	Shale
2425	Lime
2440	Lime, hard
2500	Lime
2525	Shale
2535	Shale & shells
2562	Shale
2567	Lime
2577	Shale
2675	Lime
2680	Shale
2732	Lime
2790	Shale
2805	Lime
2820	Shale
2830	Lime
2857	Shale
2870	Broken lime
2890	Shale & lime
2900	Shale
2920	Lime
2930	Shale
2950	Lime shells
2960	Shale & shells
2980	Lime
2985	Shale
2993	Lime & shale
3010	Shale
3014	Shale sandy
3018	Variety colored shale & shells
3021	Oil sand

Total Depth @ 3021'

Tops: Kansas City limestone @ 2561'
 Basal Pennsylvanian sandstone @ 3018'

Water Record: 4 BWFH 135-145
 1 BWFH 930-940
 7 BWFH 1190-1200
 7 BWFH 1612-1620
 HFW 1620-1628

RECEIVED
 8-26-41
 112-41

RECEIVED
 STATE COMMISSION
 JUL 7 1941
 CONSERVATION DIVISION
 Wichita, Kansas