


STATE OF KANSAS  
STATE CORPORATION COMMISSION  
Give All Information Completely  
Make Required Affidavit  
Mail or Deliver Report to:  
Conservation Division  
State Corporation Commission  
800 Bitting Building  
Wichita, Kansas

WELL PLUGGING RECORD

NORTH

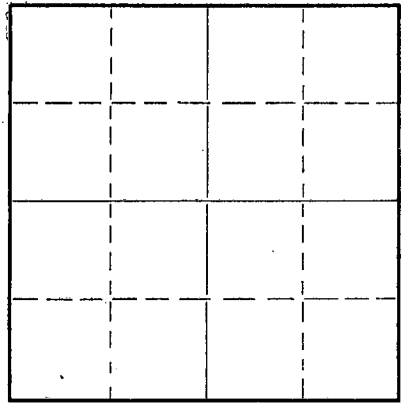

Locate well correctly on above Section Plat

Sedgewick County, Sec. 8 Twp. 26 Rge. 2 (E) (W)  
Location as "NE/CNW 1/4 SW 1/4" or footage from lines SE NW NW  
Lease Owner ~~Blumkamp~~ John B. Gaty  
Lease Name ~~Blumkamp~~ Tammey, N.D. Well No. 3  
Office Address 6600 East Central  
Character of Well (completed as Oil, Gas or Dry Hole) Dry  
Date well completed Dec. 21 19 49  
Application for plugging filed Dec. 21 19 49  
Application for plugging approved Dec. 21 19 49  
Plugging commenced Dec. 21 19 49  
Plugging completed Dec. 22 19 49  
Reason for abandonment of well or producing formation Hole full of water

If a producing well is abandoned, date of last production 19  
Was permission obtained from the Conservation Division or its agents before plugging was commenced?

Name of Conservation Agent who supervised plugging of this well Dwight Lilly  
Producing formation Burgess Depth to top Bottom Total Depth of Well 3,002 1/2 Feet  
Show depth and thickness of all water, oil and gas formations.

OIL, GAS OR WATER RECORDS

CASING RECORD

Formation	Content	From	To	Size	Put In	Pulled Out
Miss. Lime	Water	3014'	3021'	5"	2994'	2994'

Describe in detail the manner in which the well was plugged, indicating where the mud fluid was placed and the method or methods used in introducing it into the hole. If cement or other plugs were used, state the character of same and depth placed, from 3,002 1/2 feet to 2994 feet for each plug set.  
Mudded hole back to 145 feet set fifteen foot rock bridge to 130 feet. Ten sacks of cement on top of rock bridge. Mudded hole to cellar. 5 sacks of cement on top.

1-13-50  
JAN 13 1950  
STATE OF KANSAS  
Notary Public

(If additional description is necessary, use BACK of this sheet)  
Correspondence regarding this well should be addressed to  
Address

STATE OF \_\_\_\_\_, COUNTY OF \_\_\_\_\_, ss.

(employee of owner) or (owner or operator) of the above-described well, being first duly sworn on oath, says: That I have knowledge of the facts, statements, and matters herein contained and the log of the above-described well as filed and that the same are true and correct. So help me God

(Signature) May Howell  
210 N. Edgemoor Dr.  
(Address)

SUBSCRIBED AND SWORN to before me this 1st day of January, 1950  
Berenice Koochen  
Notary Public.

My commission expires January 12, 1952

PLUGGING  
SEC 8 TWP 26 R 2E  
PAGE 12 LINE 27

DRILLING LOG

WELL NAME: Timerkamp #3  
 OWNERS : J. P. Gaty  
 CONTRACTOR: Laura Jane Oil Co., Inc.

LOCATION: SE NW NW 8-26S-2E,  
 Sedgwick County  
 PRODUCTION:

DATE COM: 12/2/49  
 DATE COMP: 12/9/49

CASING RECORD: 8 5/8" @ 130'

Formation	To
Surface	130
Lime-shale	280
Lime	450
shale-shells	585
shale lime	900
shale - shells	1565
Lime-shale	2460
Lime shale	2555
Lime	2705
Lime-shale	2994 TD Rotary

I certify that the above is a true and correct copy of the log of the Timerkamp #3, SE NW NW, 8-26S-2E, Sedgwick County, Kansas, to the best of my knowledge.

LAURA JANE OIL CO., INC.,

BY H. H. Shuman

Sworn and subscribed to before me this 30th day of December, 1949

Caral T. East  
 NOTARY PUBLIC

My Comm. Expires 6/28/52

CABLE TOOL LOG

2994-95	Sand and Chert - (Hard cemented)
2995-99	V. C. Shale with Sand Inclusions
2999-3000	Mottled Black and White Hard Shale (No Sand)
3000-3007	Sandy Shale
3007-3014	Sand in Blue-Green Shale Matrix
3008	Oil Show of 10 Gallons per Hour
3014-3021	Miss. Lime - Lime and Chert
3019	HFW

**PLUGGING**  
 FILE SEC 8 T 26  
 BOOK PAGE 13 LINE 27