


Give All Information Completely
Make Required Affidavit
Mail or Deliver Report to:
Conservation Division
State Corporation Commission
211 No. Broadway
Wichita, Kansas

15-173-02008-00-00

WELL PLUGGING RECORD

T 26S NORTH R 2E

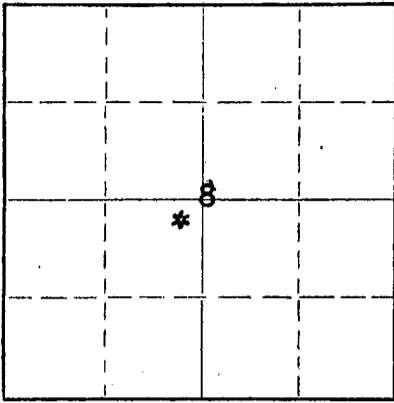

Locate well correctly on above Section Plat

Sedgwick County. Sec. 8 Twp. 26S Rge. 2E (E) (W)
Location as "NE/CNW/SW" or footage from lines NE NE SW
Lease Owner Ray Law
Lease Name Schramm Well No. 1
Office Address Box 188 - McPherson, Kansas
Character of Well (completed as Oil, Gas or Dry Hole) Oil Well
Date well completed May 12, 1949
Application for plugging filed 19
Application for plugging approved July 6, 1956
Plugging commenced July 17, 1956
Plugging completed July 19, 1956
Reason for abandonment of well or producing formation Production fell off
If a producing well is abandoned, date of last production Nov. 1955
Was permission obtained from the Conservation Division or its agents before plugging was commenced? Yes

Name of Conservation Agent who supervised plugging of this well Rael Durkee
Producing formation Burgess' Sand Depth to top 2967 Bottom 2983 Total Depth of Well 2983 Feet
Show depth and thickness of all water, oil and gas formations.

OIL, GAS OR WATER RECORDS

CASING RECORD

FORMATION	CONTENT	FROM	TO	SIZE	PUT IN	PULLED OUT
				8-5/8"	91'	None
				4 1/2" OD	2965'	2524'

Describe in detail the manner in which the well was plugged, indicating where the mud fluid was placed and the method or methods used in introducing it into the hole. If cement or other plugs were used, state the character of same and depth placed, from _____ feet to _____ feet for each plug set.

Filled the hole with sand from 2983' to 2955' and ran 4 sacks of cement. Mudded the hole to 160', set a 10' rock bridge and ran 25 sacks of cement to 65'. Mudded the hole to 25', set a rock bridge to 18' and ran 5vsacks of cement on top. Plugging completed.

Name of Plugging Contractor West Supply Co., Inc. (If additional description is necessary, use BACK of this sheet)
Address Chase, Kansas

STATE OF KANSAS COUNTY-OF MC PHERSON SS. Ray Law (employee of owner) or (owner or operator) of the above-described well, being first duly sworn on oath, says: That I have knowledge of the facts, statements, and matters herein contained and the log of the above-described well as filed and that the same are true and correct. So help me God.

(Signature) Ray Law
(Address) _____



Subscribed and sworn to before me this 20 day of July, 1956
Carroll D. Winslow Notary Public.

PLUGGING
FILE SEC 8 T 26 R 2E
BOOK PAGE 77 LINE 16

RECEIVED
AUG 2 1956
8-2-56
CONSERVATION DIVISION
Wichita, Kansas

LOCATION:
NE/NE/SW
Section 8-26-2E
Sedgwick County, Kans.

COMPANY: ECKLAND DRILLING CO.

CONTRACTOR: ECKLAND DRILLING CO.

CASING: 91' 8 5/8"

CEMENT: 50 sacks

COMMENCED: 4-25-49

1 1/2 - 2965 - 10054?
ROTARY DEPTH: 2965'

COMPLETED: 5-12-49

TOTAL DEPTH: 2983'

05-	surface
260	shale lime
348	lime
485	lime shale
635	shale lime sand
860	shale shells
1120	shale shells
1275	shale shells
1430	shale shells
1540	shale shells
1670	shale shells
1820	lime and shale
1915	shale lime
2000	shale lime
2115	lime and shale
2125	shale lime
2165	shale shells
2285	shale
2325	shale lime
2420	lime shale
2505	shale lime
2580	lime shale
2640	shale lime
2695	lime shale
2770	lime shale
2850	shale lime
2920	shale lime
2965	shale lime Total Rotary Depth
2967	shale sandy
2983	sand OIL

RECEIVED
STATE CORPORATION COMMISSION

JUL 23 1953

CONSERVATION DIVISION
Wichita, Kansas

PLUGGING

FILE SEC. 8 T. 26 R. 2E
BOOK PAGE 77 LINE 16