


STATE OF KANSAS
STATE CORPORATION COMMISSION

WELL PLUGGING RECORD

Give All Information Completely
Make Required Affidavit
Mail or Deliver Report to:
Conservation Division
State Corporation Commission
800 Bittling Building
Wichita, Kansas

Sedgwick County, Sec. 8 Twp. 26s Rge. 2 (E) (W)
NW/SE/SW

Location as "NE/CNW $\frac{1}{4}$ SW $\frac{1}{4}$ " or footage from lines
Lease Owner J. G. Ripstra
Lease Name Schramm Well No. 2
Office Address 1014 E. Douglas, Wichita, Kansas
Character of Well (completed as Oil, Gas or Dry Hole) Oil well - depleted
Date well completed September 7, 1949 19
Application for plugging filed January 20, 1953 19
Application for plugging approved January 20, 1953 19
Plugging commenced January 26 1953
Plugging completed February 3 1953
Reason for abandonment of well or producing formation Depleted

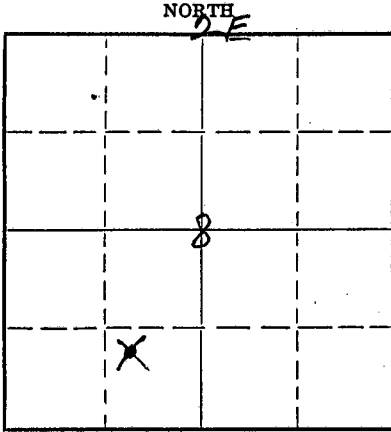

26
5

Locate well correctly on above Section Plat

If a producing well is abandoned, date of last production 19
Was permission obtained from the Conservation Division or its agents before plugging was commenced? yes Yes

Name of Conservation Agent who supervised plugging of this well D. C. Lilley
Producing formation Burgess 2990 Depth to top 2990 Bottom 2997 Total Depth of Well 2997 Feet
Show depth and thickness of all water, oil and gas formations.

OIL, GAS OR WATER RECORDS

CASING RECORD

Formation	Content	From	To	Size	Put In	Pulled Out
				5 $\frac{1}{2}$	2990	2271.22 Ft
				8-5/8"	196'	

Describe in detail the manner in which the well was plugged, indicating where the mud fluid was placed and the method or methods used in introducing it into the hole. If cement or other plugs were used, state the character of same and depth placed, from feet to feet for each plug set.

2997 - 2992 Rock
2992 - 2960 Cement 6 Sacks
2960 - 200 Heavy mud
200 - 190 Rock bridge
190 - 115 Cement 25 sacks
115 - 20 Heavy mud
20 - to base of cellar 5 sacks cement

(If additional description is necessary, use BACK of this sheet)
Name of Plugging Contractor Walker Drilling Inc.
Address 217 E. First St. Hutchinson, Kansas

STATE OF Kansas, COUNTY OF Reno, ss.
H. M. Walker (employee of owner) or (owner or operator) of the above-described well,
being first duly sworn on oath, says: That I have knowledge of the facts, statements, and matters herein contained and the log of the above-described well as filed and that the same are true and correct. So help me God.

(Signature) H. M. Walker
Hutchinson, Kansas (Address)

SUBSCRIBED AND SWORN to before me this 5th day of February, 1953
Caleb L. Kirby Notary Public.

My commission expires 9-9-54

23-8390-s 6-51-20M
PLUGGING
FILE SEC 8 T 26 R 2 E
BOOK PAGE 74 LINE 7

RECEIVED
STATE CORPORATION COMMISSION
FEB 9 - 1953
2-9-53
CONSERVATION DIVISION
Wichita, Kansas

LOCATION: Schram 1C
NExNExSEx
Nw SE SW Sec.8-26S-2E
Sedgwick County, Kansas

COMPANY: Charles L. Carlock

CONTRACTOR: Eckland Drilling Co.


Surface: 196' 8 5/8"
50 Sacks Cement

Commenced: 8-29-49

Completed: 9-7-49

Total Depth:
Rotary 2965'

'' 88	surface
140	shale shells
150	shale shells
285	lime shale
420	lime shale
	lime shale
600	lime shale
650	sand
820	lime shale
990	lime shale
1065	shale
1300	shale
1375	lime shale
1485	shale
1520	lime shale
1650	lime shale
1650	lime shale
1860	lime shale
1980	lime shale
2170	lime shale
2330	lime shale
2340	lime shale
2310	lime
2420	lime shale
2510	lime shale
2519	lime shale
2592	K.C.lime
2662	K.C.lime
2685	lime
2745	shale
2840	lime shale
2925	lime shale
2963	shale
2965	sand Total Rotary Depth.

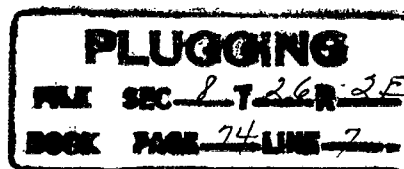

RECEIVED
STATE CORPORATION COMMISSION

FEB 2 - 1953

CONSERVATION DIVISION
Wichita, Kansas