


WELL PLUGGING RECORD

Get All Information Completely
Make Required Affidavit
Mail or Deliver Report to:
Conservation Division
State Corporation Commission
800 Bitting Building
Wichita, Kansas

Sedgwick County, Sec. 8 Twp. 26S Rge. 2 (E) (W)
Location as "NE/CNW $\frac{1}{4}$ SW $\frac{1}{4}$ " or footage from lines N/2 NE/4 NW/4
Lease Owner John P. Gaty
Lease Name Koontz Well No. 2
Office Address 11 Cypress Drive, Wichita, Kansas
Character of Well (completed as Oil, Gas or Dry Hole) Dry Hole
Date well completed July 8 19 50
Application for plugging filed July 10 19 50
Application for plugging approved July 10 19 50
Plugging commenced July 12 19 50
Plugging completed July 12 19 50
Reason for abandonment of well or producing formation Water
If a producing well is abandoned, date of last production 19
Was permission obtained from the Conservation Division or its agents before plugging was commenced? Yes

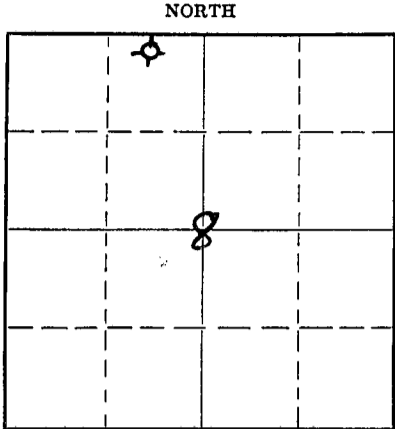

Locate well correctly on above Section Plat

Name of Conservation Agent who supervised plugging of this well D. C. Lilley
Producing formation Burgess Sand Depth to top 3003 Bottom 3006 Total Depth of Well 3006 $\frac{1}{2}$ Feet
Show depth and thickness of all water, oil and gas formations.

OIL, GAS OR WATER RECORDS

CASING RECORD

Formation	Content	From	To	Size	Put In	Pulled Out

Describe in detail the manner in which the well was plugged, indicating where the mud fluid was placed and the method or methods used in introducing it into the hole. If cement or other plugs were used, state the character of same and depth placed, from _____ feet to _____ feet for each plug set.

3 sacks of cement on bottom
Mud to 140'
~~15' rock bridge with 12 sacks cement to 125'~~
Mud to 25'
10' rock bridge with 5 sacks cement in cellar

(If additional description is necessary, use BACK of this sheet)

Correspondence regarding this well should be addressed to John P. Gaty
Address 11 Cypress Drive
Wichita, Kansas

STATE OF Kansas, COUNTY OF Sedgwick, ss.

Wm. Vallandingham (employee of owner) or (owner or operator) of the above-described well, being first duly sworn on oath, says: That I have knowledge of the facts, statements, and matters herein contained and the log of the above-described well as filed and that the same are true and correct. So help me God.

(Signature) *Wm. Vallandingham*

555 North Topeka, Wichita, Kansas
(Address)

SUBSCRIBED AND SWORN to before me this 31st day of July

E. G. Hayes
Notary Public.

My commission expires Feb. 4, 1952

22-7877-8 4-49-10M
PLUGGING
FILE SEC 8 T 26 R 2 E
BOOK PAGE 15 LINE 1

AUG 1 - 1950
8-1-50
STATE CORPORATION COMMISSION
KANSAS

WELL LOG - KUNTZ #2

OPERATOR: Mr. J. P. Gaty
c/o Beech Aircraft Corp.
Wichita, Kansas

LOCATION: N/2 NE/4 NW/4
Section 8, Township 26
South, Range 2 East
Sedgwick County, Kansas

CONTRACTOR: Morrison Drilling Company, Inc.
P. O. Drawer 712
El Dorado, Kansas

PRODUCTION: Dry

FARM: ^{KUNTZ} Kuntz WELL NO. 2

Elev. 1429 (26)

Date Commenced: June 27, 1950

Date Completed: July 3, 1950

Total Depth: 2985 feet

<u>From</u>	<u>To</u>	<u>Formation</u>	<u>From</u>	<u>To</u>	<u>Formation</u>
115	125	Plug & Cement	1847	1945	Lime & Shale Brks.
125	170	Broken Lime	1945	2015	Lime & Shale Strks
170	190	Shale & Shells	2015	2180	Shale & Shells
190	240	Lime, Shale, & Hard Shells	2180	2200	Lime
240	275	Lime & Shells	2200	2298	Shale
275	294	Shale & Lime	2298	2450	Lime
294	320	Lime	2450	2538	Shale
320	340	Shale	2538	2682	Lime
340	345	Red Rock	2682	2776	Shale
345	395	Shale & Lime	2776	2783	Lime
395	405	Shale	2783	2798	Lime & Shale Brks.
405	410	Red Bed	2798	2820	Lime
410	665	Lime & Shale Brks.	2820	2835	Shale & Shells
665	675	Red Bed	2835	2854	Lime & Shale Strks
675	790	Shale & Shells	2854	2960	Lime & Shale Brks.
790	935	Lime & Shale	2960	2985	Lime & Shale
935	1005	Shale & Lime Strks.	2985		Total Depth.
1005	1075	Shale & Shells			
1075	1082	Red Bed			
1082	1110	Shale & Lime			
1110	1115	Red Bed			
1115	1135	Shale & Lime Strks.			
1135	1250	Shale & Sandy Strks.			
1250	1305	Shale & Shells			
1305	1335	Lime			
1335	1400	Lime & Shale Brks.			
1400	1515	Shale & Shells			
1515	1565	Lime			
1565	1630	Sandy Shale			
1630	1670	Lime			
1670	1705	Shale			
1705	1715	Lime			
1715	1765	Shale & Lime Brks.			
1765	1847	Shale & Lime Brks.			

Cable Tool Log -
 2985-86 - Yellow Sandy shale -
 2986-3003 - Hard white - hard
 yellow and hard red shale
 lining white shale -
 3003-3006 - Burgess Sand - water
 1 Bw/ke.
 3006-3006 1/2 - chert -

I hereby certify that the foregoing is a true and correct copy of the Well Log for the Kuntz #2 well drilled for Mr. J. P. Gaty and Completed July 3, 1950.

[Signature]
C. W. Wilson
Secretary-Treasurer

STATE OF KANSAS)
) ss.
-COUNTY OF BUTLER -)

SUBSCRIBED AND SWORN TO, Before the undersigned, a Notary Public, in and for the County and State aforesaid this 10th day of July, 1950.

RECEIVED
PLUGGING
 FILE SEC. 21 2626
 AUG 1 1950
 Notary Public
 STATE OF KANSAS
 COMMISSION

My Commission Expires January 10, 1951.