


STATE OF KANSAS
STATE CORPORATION COMMISSION

WELL PLUGGING RECORD

Give All Information Completely
Make Required Affidavit
Mail or Deliver Report to
Conservation Division
State Corporation Comm.
245 North Water
Wichita, KS 67202

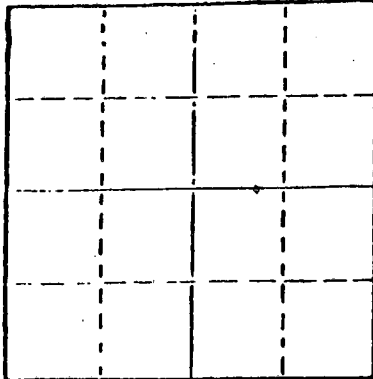

Locate well correctly on above
Section Plat /

Sedgwick County. Sec. 34 Twp. 26S Rge. 2E E/W
Location as "NE/CNW $\frac{1}{4}$ SW $\frac{1}{4}$ " or footage from lines
N/2 Sw

Lease Owner F & M Oil Company, Inc.

Lease Name Wheeler Well No. 1

Office Address 422 Union Center Bldg. Wichita, Ks.

Character of Well (Completed as Oil, Gas or Dry Hole)

Dry hole

Date Well completed 5-6-81 19

Application for plugging filed 5-6-81 19

Application for plugging approved 5-6-81 19

Plugging commenced 5-6-81 19

Plugging completed 5-6-81 19

Reason for abandonment of well or producing formation

If a producing well is abandoned, date of last production 19

Was permission obtained from the Conservation Division or
its agents before plugging was commenced? yes

Name of Conservation Agent who supervised plugging of this well Thompson
Producing formation Depth to top Bottom Total Depth of Well 3378

Show depth and thickness of all water, oil and gas formations.

OIL, GAS OR WATER RECORDS

CASING RECORD

| FORMATION | CONTENT | FROM | TO | SIZE | PUT IN | PULLED OUT |
|-----------|---------|------|-----|-------|--------|------------|
| Surface | | 0 | 256 | 8 5/8 | 256 | 0 |
| | | | | | | |
| | | | | | | |
| | | | | | | |

Describe in detail the manner in which the well was plugged, indicating where the mud fluid
was placed and the method or methods used in introducing it into the hold. If cement or other
plugs were used, state the character of same and depth placed, from feet to
feet for each plug set.

Rotary Mud & plug 35 sx @ 280'

Rotary mud & plug 12 sx @ 50'

Rathole plugged w/3 sxs

RECEIVED

STATE CORPORATION COMMISSION

MAY 18 1981

5-18-81

CONSERVATION DIVISION

Wichita, Kansas

(If additional description is necessary, use BACK of this sheet)

Name of Plugging Contractor Brandt Drilling Co., Inc.

STATE OF Kansas COUNTY OF Sedgwick, ss.

Timothy E. Brandt

(employee of owner) or (owner or operator)

of the above-described well, being first duly sworn on oath, says: That I have knowledge of
the facts, statements, and matters herein contained and the log of the above-described well
as filed and that the same are true and correct. So help me God.

(Signature)

1200 Douglas Building

Wichita, Kansas (Address)

SUBSCRIBED AND SWORN TO before me this 14 day of May, 1981

My commission expires April 21, 1984

Sheryl Hylton

Notary Public.

