


STATE OF KANSAS
STATE CORPORATION COMMISSION

WELL PLUGGING RECORD

Give All Information Completely
Make Required Affidavit
Mail or Deliver Report to:
Conservation Division
State Corporation Commission
800 Bitting Building
Wichita, Kansas

Sedgwick County. Sec. 29 Twp. 26 Rge. 2 (E) (W)
Location as "NE/CNW%SW%" or footage from lines. SW/4 SW/4 NW/4
Lease Owner John P. Gaty
Lease Name Sample A Well No. 3
Office Address 11 Cypress Dr., Wichita, Kansas
Character of Well (completed as Oil, Gas or Dry Hole) Oil
Date well completed June 30 19 49
Application for plugging filed August 23, 19 56
Application for plugging approved August 24, 19 56
Plugging commenced August 29, 19 56
Plugging completed September 10, 19 56
Reason for abandonment of well or producing formation Depleted

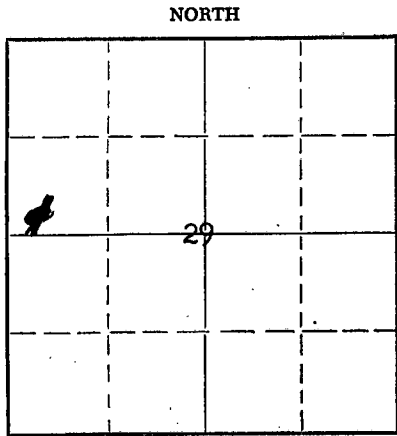

Locate well correctly on above
Section Plat

If a producing well is abandoned, date of last production July 19 56
Was permission obtained from the Conservation Division or its agents before plugging was commenced? Yes

Name of Conservation Agent who supervised plugging of this well Ruel Durkee
Producing formation _____ Depth to top _____ Bottom _____ Total Depth of Well 2953 Feet
Show depth and thickness of all water, oil and gas formations.

OIL, GAS OR WATER RECORDS

CASING RECORD

FORMATION	CONTENT	FROM	TO	SIZE	PUT IN	PULLED OUT

Describe in detail the manner in which the well was plugged, indicating where the mud fluid was placed and the method or methods used in introducing it into the hole. If cement or other plugs were used, state the character of same and depth placed, from _____ feet to _____ feet for each plug set.

Sand from 2953 up to 2940. Six sacks cement.
Mud from 2940 to 200' set solid rock bridge at 200'
25 sacks cement. Mud to bottom of 8' cellar 10 sacks cement.

(If additional description is necessary, use BACK of this sheet)


Name of Plugging Contractor John P. Gaty
Address 11 Cypress Dr., Wichita, Kansas

STATE OF Kansas, COUNTY OF Sedgwick, ss.
Earl Wentworth (employee of owner) of the above-described well, being first duly sworn on oath, says: That I have knowledge of the facts, statements, and matters herein contained and the log of the above-described well as filed and that the same are true and correct. So help me God.

(Signature) Earl Wentworth
734 Pippin Ct Wichita Kas.
(Address)

SUBSCRIBED AND SWORN to before me this 12th day of September, 19 56

My commission expires December 12, 1959

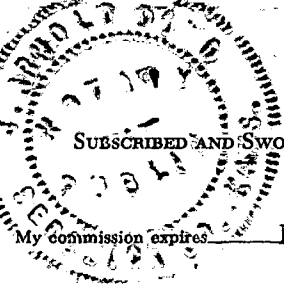

J. Arnold Dowd
Notary Public.

PLUGGING
FILE SEC. 29 T. 26 R. 2E
BOOK PAGE 92 LINE 41

RECEIVED
SEP 14 1956
9-14-56
CONSERVATION DIVISION
Wichita, Kansas

WELL LOG

John P. Gaty, Owner - Sample No. 3 - Section 29, Township 26, Range 2 East, SW SW NW,
Sedgwick County, Kansas

Figures Indicate Bottom of Formation

0	to	8	Cellar	785	to	795	Shale	1990	to	2000	Lime
		15	Clay			815	Lime			2140	Shale
		95	Shale			830	Shale			2160	Lime
		110	Lime			875	Lime			2170	Shale
		120	Shale			935	Shale			2205	Lime
		125	Lime			940	Lime			2210	Shale
		130	Shale			985	Shale			2215	Lime
		135	Lime			990	Lime			2235	Shale
		145	Shale			1020	Shale			2305	Lime
		155	Lime			1025	Red Rock			2325	Shale
		165	Shale			1095	Shale			2380	Lime
		190	Lime			1100	Lime			2385	Shale
		195	Shale			1155	Sand			2420	Lime
		200	Lime			1175	Lime			2500	Shale
		255	Shale & Shells			1275	Shale			2530	Lime
		265	Lime			1290	Lime			2535	Shale
		290	Shale			1310	Shale			2618	Lime
		295	Red Rock			1325	Lime			2623	Shale
		320	Shale			1330	Shale			2670	Lime
		345	Lime			1355	Lime			2730	Shale
		360	Shale			1425	Shale			2745	Lime
		365	Red Rock			1430	Lime			2760	Shale
		375	Shale			1448	Sand			2780	Lime
		420	Lime			1500	Lime			2795	Shale
		430	Shale			1530	Shale			2865	Lime
		510	Lime			1535	Lime			2875	Shale
		520	Shale			1565	Sand			2882	Lime
		550	Shale & Shells			1630	Lime			2910	Shale
		555	Shale			1655	Shale			2930	Shale & Shells
		560	Lime			1680	Lime			2944	Shale
		565	Shale			1690	Shale			2949	Sand
		575	Lime			1710	Lime			2951	- Total Depth
		580	Shale			1714	Shale				
		605	Lime			1720	Lime				
		610	Shale			1765	Shale				
		615	Red Rock			1775	Lime				
		625	Lime			1780	Shale				
		650	Shale			1825	Lime				
		655	Lime			1875	Shale				
		685	Shale			1885	Lime				
		705	Lime			1900	Shale				
		740	Shale			1940	Lime				
		755	Lime			1965	Shale				
		775	Shale			1975	Lime				
		785	Lime			1990	Shale				

PLUGGING

FILE SEC. 29 T. 26 R. 2E
BOOK PAGE 92 LINE 41

Well Log

John P. Gaty - Sample No. 3 - Continued

Spudded - June 2, 1949
Completed - June 30, 1949

Top
Kansas City - 2500

Pipe Record

13-3/8" - 860
10" - 1565
8" - 2515
7" - 2605
5" - 2945

Water Record

3 bailers per hour - 1110
15 " " " - 1145
4 " " " - 2280 - 2290
7 " " " - 2335
H.F.W. - 2580 - 2590

State of Kansas)
County of Sedgwick)ss

I, C. A. Black, Drilling Contractor of the above-described well, being first duly sworn on oath, declare: That, I have knowledge of the facts, statements and matters herein contained pertaining to the log of the above-described well as filed, and that the same are true and correct.

C. A. Black, Partner

Subscribed and sworn to before me this 13th day of July, 1949.

Notary Public

My commission expires _____.

PLUGGING
FILE SEC..... T..... R.....
BOOK PAGE..... LINE.....