

9


STATE OF KANSAS
STATE CORPORATION COMMISSION

Form CP-4

WELL PLUGGING RECORD

Give All Information Completely
Make Required Affidavit
Mail or Deliver Report to:
Conservation Division
State Corporation Commission
212 No. Market
Wichita, Kansas

NORTH

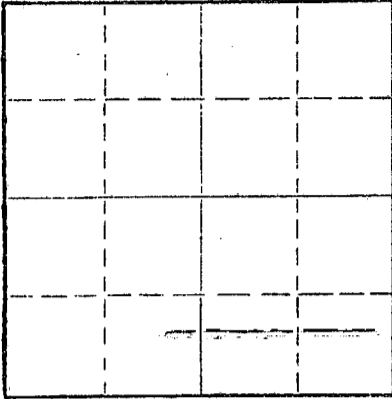

Locate well correctly on above
Section Plat

Butler

County. Sec. 11 Twp. 26 Rge. 3 (E) (XX)

Location as "NE/CNW/SW" or footage from lines NW NE NE

Lease Owner Oilfield Supply & Trading, Inc.

Lease Name Bond

Well No. 2-A

Office Address 430 Greenwood, Wichita, Kansas 67211

Character of Well (completed as Oil, Gas or Dry Hole) Dry Hole

Date well completed 5-28-70 19

Application for plugging filed 7-1-70 19

Application for plugging approved 7-2-70 19

Plugging commenced 7-3-70 19

Plugging completed 7-3-70 19

Reason for abandonment of well or producing formation Dry Hole

If a producing well is abandoned, date of last production None 19

Was permission obtained from the Conservation Division or its agents before plugging was commenced? Yes

Name of Conservation Agent who supervised plugging of this well Ted Dewey

Producing formation Mississippi Depth to top 2740 Bottom 2746 Total Depth of Well 2746 Feet

Show depth and thickness of all water, oil and gas formations.

OIL, GAS OR WATER RECORDS

CASING RECORD

FORMATION	CONTENT	FROM	TO	SIZE	PUT IN	PULLED OUT
Mississippi	Water from 2740-2746			4 1/2"	2740	2260

Describe in detail the manner in which the well was plugged, indicating where the mud fluid was placed and the method or methods used in introducing it into the hole. If cement or other plugs were used, state the character of same and depth placed, from _____ feet to _____ feet for each plug set.

Move in - dig deadman holes - set rig.

Rig up - sand from 2754 to 2740 - dump 4 sax cement - pull slips.

Work pipe 19" - shoot @ 2510 - 2420 - 2324 - 2260 - pull 40 joints.

Pull 32 joints pipe - bail hole to 220 ft. - rock bridge to 200 ft.

Dump 3 1/2 yds ready mix cement to surface - tear down.

RECEIVED
STATE CORPORATION COMMISSION
7-13-70
JUL 13 1970
CONSERVATION DIVISION
Wichita, Kansas

(If additional description is necessary, use BACK of this sheet)

Name of Plugging Contractor Ralph Comstock, 320 N. Park, Stafford, Kansas

Address _____

STATE OF Kansas, COUNTY OF Sedgwick, ss.

W. R. Justice

(XXXXXXXXXX) or (owner or operator)

well, being first duly sworn on oath, says: That I have knowledge of the facts, statements, and matters herein contained and the log of the above-described well as filed and that the same are true and correct. So help me God.

(Signature)


W. R. Justice

430 Greenwood, Wichita, Kansas 67211
(Address)

SUBSCRIBED AND SWORN TO before me this 10th day of July

Ethel Spicer
Ethel Spicer

My commission expires May 14, 1972

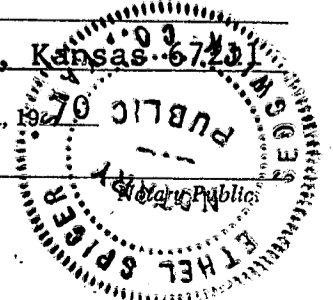

TRIANGLE DRILLING

324 North Orchard
EL DORADO, KANSAS

11-26-8E

RP

To Oil Field Supply & Trading Inc.

Invoice No. _____

430 Greenwood, Wichita, Kansas

Date June 4, 1970

For Month Of _____

Lease Block 2-A NW NE NE 11-26-8E Butler County, Kansas

WELL LOG

0	-----	3	Soil
3	-----	560	Lime and Shale
560	-----	1725	Shale and Lime
1725	-----	2025	Lime and Shale
2025	-----	2125	Lime
2125	-----	2215	Lime and Shale
2215	-----	2237	Shale and Lime
2237	-----	2368	Sand and Shale
2368	-----	2430	Lime
2430	-----	2680	Shale and Lime
2680	-----	2742	Lime and Shale
2742	-----	2746	Chat, Miss. R.T.D.

RECEIVED
STATE CORPORATION COMMISSION
JUL 2 1970
CONSERVATION DIVISION
Wichita, Kansas