


STATE OF KANSAS
STATE CORPORATION COMMISSION

Form CP-4

WELL PLUGGING RECORD

Give All Information Completely
Make Required Affidavit
Mail or Deliver Report to:
Conservation Division
State Corporation Commission

P. O. Box 17027
Wichita, Kansas 67217
NORTH

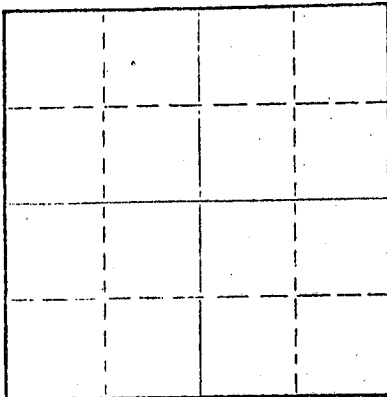

Locate well correctly on above
Section Plat

Butler County, Sec. 11 Twp. 26S Rge. 3E (E) (W)

Location as "NE/CNW/SW" or footage from lines NE NE NW
Lease Owner Oilfield Supply & Trading, Inc.
Lease Name Stareck Well No. 1
Office Address 430 Greenwood, Wichita, KS 67211
Character of Well (completed as Oil, Gas or Dry Hole) Oil Well
Date well completed January 30, 19 74
Application for plugging filed _____ 19 _____
Application for plugging approved _____ 19 _____
Plugging commenced January 25, 19 74
Plugging completed January 30, 19 74
Reason for abandonment of well or producing formation Non-commercial

If a producing well is abandoned, date of last production _____ 19 _____
Was permission obtained from the Conservation Division or its agents before plugging was commenced? Yes

Name of Conservation Agent who supervised plugging of this well Ted Dewey
Producing formation _____ Depth to top _____ Bottom _____ Total Depth of Well 2740' Feet
Show depth and thickness of all water, oil and gas formations.

OIL, GAS OR WATER RECORDS

CASING RECORD

FORMATION	CONTENT	FROM	TO	SIZE	PUT IN	PULLED OUT
				4 1/2"		2265' (ft.)

Describe in detail the manner in which the well was plugged, indicating where the mud fluid was placed and the method or methods used in introducing it into the hole. If cement or other plugs were used, state the character of same and depth placed, from 2740 feet to 2422 feet for each plug set.

Four (4) sacks cement from 2470' to 2422' with dump bailer. Mud from 2422' to 210'. Rock bridge from 210' to 200'. Twenty (20) sacks cement from 200' to 140'. Mud from 140' to 40'. Rock bridge from 40' to 35'. Ten (10) sacks cement from 35' to top.

RECEIVED
STATE CORPORATION COMMISSION
2-21-74
FEB 21 1974
CONSERVATION DIVISION
Wichita, Kansas

(If additional description is necessary, use BACK of this sheet)


Name of Plugging Contractor El Dorado Supply Company
Address 764 Oil Hill Rd., El Dorado, KS 67042

STATE OF Kansas, COUNTY OF Butler, ss.
Debra A. Brownrigg (employee of owner) or ~~owner or operator~~ of the above-described

well, being first duly sworn on oath, says: That I have knowledge of the facts, statements, and matters herein contained and the log of the above-described well as filed and that the same are true and correct. So help me God.

(Signature) Debra A. Brownrigg
750 Oil Hill Rd., El Dorado, Kan. (Address)

19th day of February, 1974

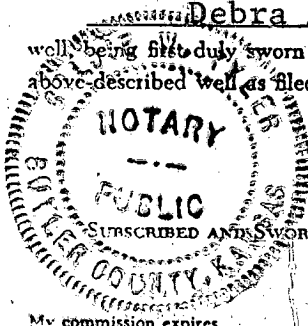

Goldie W. Tyler Notary Public.

508 East M...
Wichita, Kansas

TRIANGLE DRILLING

324 North Orchard
EL DORADO, KANSAS

11-26-3E
NE NE NW

Elev. 1323' KB

JUL 4 1970

To Oil Field Drilling & Supply
Wichita, Kansas

Invoice No. _____

Date March 11 1970

For Month Of _____

Lease Starock # 1 Sec. 13, T4N, R11E, S3E Butler County, Kansas

WELL LOG

*p. 40 Box tr. with
Miss*

0	-----	3	Soil
3	-----	44	Lime and Shale
44	-----	169	Lime and Shale
169	-----	230	Shale and Lime
230	-----	530	Lime and Shale
530	-----	715	Lime and Shale
715	-----	1100	Shale and Lime <i>Stops</i>
1100	-----	1280	Shale and Lime
1280	-----	1520	Shale and Lime
1520	-----	1905	Shale and Lime
1905	-----	1975	Shale and Lime
1975	-----	2126	Shale and Lime
2126	-----	2345	Lime and Shale
2345	-----	2410	Lime
2410	-----	2484	Lime and Shale
2484	-----	2630	Shale and Lime
2630	-----	2733	Shale and Lime
2733	-----	2740	Miss. R.T.B.

Mississippi 2733

RECEIVED
STATE CORPORATION COMMISSION
FEB 26 1974
CONSERVATION DIVISION
Wichita, Kansas