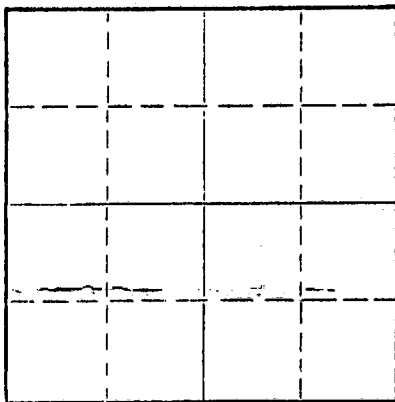


STATE OF KANSAS
STATE CORPORATION COMMISSION

Give All Information Completely
Make Required Affidavit
Mail or Deliver Report to:
Conservation Division
State Corporation Commission
212 No. Market
Wichita, Kansas 67202

NORTH

Locate well correctly on above
Section Plat

WELL PLUGGING RECORD

Butler County, Sec. 11 Twp. 26 Rge. 3 E (E) (W)
Location as "NE/CNW/SW" or footage from lines NE NE SW
Lease Owner Oil Field Supply & Trading Inc.
Lease Name Novascone Well No. 1
Office Address 430 Greenwood, Wichita, Kansas
Character of Well (completed as Oil, Gas or Dry Hole) Dry Hole
Date well completed 5-14-70 19
Application for plugging filed 5-14-70 19
Application for plugging approved 5-14-70 19
Plugging commenced 5-14-70 19
Plugging completed 5-14-70 19
Reason for abandonment of well or producing formation
If a producing well is abandoned, date of last production 19
Was permission obtained from the Conservation Division or its agents before plugging was commenced? Yes

Name of Conservation Agent who supervised plugging of this well Ted Dewey
Producing formation Depth to top Bottom Total Depth of Well 2770 Feet
Show depth and thickness of all water, oil and gas formations.

OIL, GAS OR WATER RECORDS

CASING RECORD

FORMATION	CONTENT	FROM	TO	SIZE	PUT IN	PULLED OUT

Describe in detail the manner in which the well was plugged, indicating where the mud fluid was placed and the method or methods used in introducing it into the hole. -If cement or other plugs were used, state the character of same and depth placed, from feet to feet for each plug set.

Mud to 195' 1/2 sx. of hulls set plug 20 sx. of cement, mud to 40'
1/2 sx. of hulls set plug 8 sx. cement to top 2 sx. cement in rat-hole

RECEIVED
STATE CORPORATION COMMISSION
MAY 20 1970
CONSERVATION DIVISION
Wichita, Kansas
5-20-70

(If additional description is necessary, use BACK of this sheet)
Name of Plugging Contractor Triangle Drilling Co.
Address 324 N. Orchard, El Dorado, Kansas

STATE OF Kansas, COUNTY OF Butler, ss.
Harry Hughes (employee of owner) or (owner or operator) of the above-described well, being first duly sworn on oath, says: That I have knowledge of the facts, statements, and matters herein contained and the log of the described well as filed and that the same are true and correct. So help me God.

(Signature)

(Address)

Subscribed and sworn to before me this

18

day of

May

1970

My commission expires

Nov. 12 1972

Notary Public.

TRIANGLE DRILLING

324 North Orchard
EL DORADO, KANSAS

To Oil Field Supply & Trading Inc.

Invoice No. _____

430 Greenwood

Date May 17, 1970

Wichita, Kansas

For Month Of _____

Lease Navascone NE NE SW Butler County, Kansas

WELL LOG

0	5 soil
5	196 Shale and Lime
196	440 Lime
440	700 Lime And Shale
700	2045 Shale and Lime
2045	2069 Shale
2069	2200 Lime
2200	2290 Lime And Shale
2290	2480 Lime
2480	2755 Lime and Shale
2755	2770 Lime Miss. R.T.D.

RECEIVED
STATE CORPORATION COMMISSION
MAY 20 1970
CONSERVATION DIVISION
Wichita, Kansas