


STATE OF KANSAS
STATE CORPORATION COMMISSION
Give All Information Completely
Make Required Affidavit
Mail or Deliver Report to:
Conservation Division
State Corporation Commission
211 No. Broadway
Wichita, Kansas

Form CP-4

WELL PLUGGING RECORD

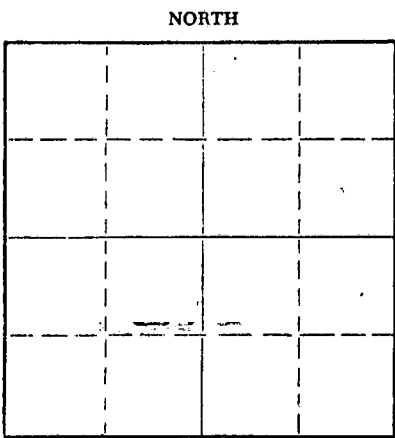

Locate well correctly on above
Section Plat

Butler County. Sec. 16 Twp. 26 Rge. 3 (E) (W)
Location as "NE/CNW&SW&" or footage from lines NE SE NW
Lease Owner Catt Drilling Co., Inc.
Lease Name Phares Well No. 1
Office Address Box 427, Augusta, Kans.
Character of Well (completed as Oil, Gas or Dry Hole) Dry hole
Date well completed June 20 1963
Application for plugging filed June 20 1963
Application for plugging approved June 20 1963
Plugging commenced June 21 1963
Plugging completed June 21 1963
Reason for abandonment of well or producing formation Dry hole

If a producing well is abandoned, date of last production 19
Was permission obtained from the Conservation Division or its agents before plugging was commenced? yes

Name of Conservation Agent who supervised plugging of this well Paul Turpin - Clearwater, Kans.
Producing formation Depth to top Bottom Total Depth of Well 2819 Feet
Show depth and thickness of all water, oil and gas formations.

OIL, GAS OR WATER RECORDS

CASING RECORD

FORMATION	CONTENT	FROM	TO	SIZE	PUT IN	PULLED OUT

Describe in detail the manner in which the well was plugged, indicating where the mud fluid was placed and the method or methods used in introducing it into the hole. If cement or other plugs were used, state the character of same and depth placed, from feet to feet for each plug set.

Mud to 200' - Plug and 1/2 sk. hulls - 15 sks. cement
Mud to 30' - Set plug - 1/2 sk. hulls - 8 sks. cement
2 sks. cement in rat hole

RECEIVED
STATE CORPORATION COMMISSION

JUL 1 1963
7-1-63

CONSERVATION DIVISION
Wichita, Kansas

(If additional description is necessary, use BACK of this sheet)

Name of Plugging Contractor Catt Drilling Co., Inc.
Address Box 427, Augusta, Kans.

STATE OF Kansas, COUNTY OF Butler, ss.
George W. Catt (employee of owner) or (owner or operator) of the above-described well, being first duly sworn on oath, says: That I have knowledge of the facts, statements, and matters herein contained and the log of the above-described well as filed and that the same are true and correct. So help me God.

(Signature) George W. Catt

(Address)

SUBSCRIBED AND SWORN TO before me this 28 day of October, 1963

My commission expires October 6, 1963

Notary Public.

(Handwritten mark)

Catt Drilling Co., Inc.
Phares #1
NE SE NW Sec. 16-26-3E
Butler County, Kansas

W E L L L O G
Started June 14, 1963
Completed June 20, 1963
R. T. D. 2819'

0-----	143	lime
143-----	160	lime w/shale
160-----	440	shale and shells
440-----	640	shale and lime
640-----	915	shale w/lime
915-----	1315	shells and shale
1315-----	1495	shale and shells
1495-----	1650	shale w/lime
1650-----	1800	shale and lime
1800-----	1990	shale and lime
1990-----	2145	lime w/shale
2145-----	2250	shale and lime
2250-----	2400	shale
2400-----	2523	shale w/lime
2523-----	2621	lime and shale
2621-----	2635	lime
2635-----	2715	shale and lime
2715-----	2806	shale w/lime
2806-----	2819	lime
2819-----		R. T. D.

RECEIVED
STATE CORPORATION

JUL 1 1963

CONSERVATION DIVISION
Wichita, Kansas