

STATE OF KANSAS
STATE CORPORATION COMMISSION

WELL PLUGGING RECORD

Give All Information Completely
Make Required Affidavit
Mail or Deliver Report to
Conservation Division
State Corporation Comm.
245 North Water
Wichita, KS 67202

Butler County, Sec. 16 Twp. 26s Rge. 3 E/W
Location as "NE/CNW $\frac{1}{4}$ SW $\frac{1}{4}$ " or footage from lines


C NW NW
Lease Owner Kansas Petroleum, Inc.
Lease Name Poling Well No. 1
Office Address 200 E. First, Suite 100, Wichita, KS 67202
Character of Well (Completed as Oil, Gas or Dry Hole)
Dry Hole

Date Well completed 12-8 1980
Application for plugging filed 12-8 1980
Application for plugging approved 12-8 1980
Plugging commenced 12-8 1980
Plugging completed 12-8 1980
Reason for abandonment of well or producing formation

If a producing well is abandoned, date of last production 19

Was permission obtained from the Conservation Division or its agents before plugging was commenced? Yes

Name of Conservation Agent who supervised plugging of this well Don Thompson
Producing formation Depth to top Bottom Total Depth of Well 2841'
Show depth and thickness of all water, oil and gas formations.

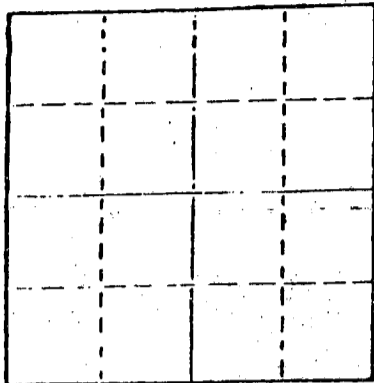

Locate well correctly on above Section Plot

OIL, GAS OR WATER RECORDS

CASING RECORD

FORMATION	CONTENT	FROM	TO	SIZE	PUT IN	PULLED OUT
				8 5/8"	214'	none

Describe in detail the manner in which the well was plugged, indicating where the mud fluid was placed and the method or methods used in introducing it into the hold. If cement or other plugs were used, state the character of same and depth placed, from feet to feet for each plug set.

Mud to 210', hulls, plug, 25 sx cement
Mud to 40' hulls, plug, 12 sx cement
3 sx in rathole


(If additional description is necessary, use BACK of this sheet)

Name of Plugging Contractor White & Ellis Drilling, Inc.
401 East Douglas, Suite 500, Wichita, KS 67202

STATE OF KANSAS COUNTY OF SEDGWICK, ss.
Ernest Sifford (employee of owner) or (owner or operator)
of the above-described well, being first duly sworn on oath, says: That I have knowledge of the facts, statements, and matters herein contained and the log of the above-described well as filed and that the same are true and correct. So help me God.

(Signature) Ernest Sifford
401 E. Douglas - Suite, Wichita, Ks.
(Address) 67202

SUBSCRIBED AND SWORN TO before me this 24th day of December, 19 80.

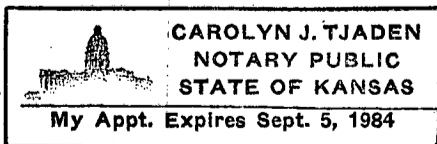

Carolyn J. Tjaden
Carolyn J. Tjaden Notary Public.

RECEIVED
STATE CORPORATION COMMISSION

DEC 29 1980
12-29-80
CONSERVATION DIVISION
Wichita, Kansas

DRILLERS LOG

OPERATOR: Kansas Petroleum, Inc., 200 E. First, Suite 100, Wichita, KS 67

CONTRACTOR: White & Ellis Drilling, Inc., Box 448, El Dorado, Kansas 67042

Lease Name Poling Well No. 1

Sec. 16 T. 26S R. 3E Spot C NW NW

County Butler State Kansas Elevation _____

Casing Record:

Surface: 8 5/8" @ 214' with _____ Sxs.

Production: _____ @ _____ with _____ Sxs.

Type Well: D & A Total Depth 2841'

Drilling Commenced: 12-3-80 Drilling Completed 12-8-80

Formation	From	To	Tops
Cellar	0	7	Mississippi 2774
Shale, Lime	7	2240	
Lime	2240	2530	
Shale, Lime	2530	2774	
Lime	2774	2841	

COMPLETION RECORD

Liner Record: Size _____ From _____ To _____

Cementing Record: _____ Sacks _____

Perforating Record:

Formation	Perforated Interval	Number Shots

Initial Production: _____

Electric Log _____ Type and Depths Covered _____

RECEIVED
STATE CORPORATION COMMISSION

DEC 29 1980

CONSERVATION DIVISION
Wichita, Kansas