

RP

STATE OF KANSAS
STATE CORPORATION COMMISSION


Form CP-4

Give All Information Completely
Make Required Affidavit
Mail or Deliver Report to:
Conservation Division
State Corporation Commission
212 No. Market
Wichita, Kansas

WELL PLUGGING RECORD

Butler County. Sec. 16 Twp. 26 Rge. 3 (E) (W)
Location as "NE/CNW/SW" or footage from lines NW NW NE
Lease Owner SE RO BEE Drlg. Co.
Lease Name Blue Well No. 1
Office Address 5301 N. Broadway Wichita, Kansas
Character of Well (completed as Oil, Gas or Dry Hole) D & A
Date well completed 5-30-66 1966
Application for plugging filed 7-28-66 1966
Application for plugging approved 7-29-66 1966
Plugging commenced 8-1-66 1966
Plugging completed 8-2-66 1966
Reason for abandonment of well or producing formation dry

NORTH

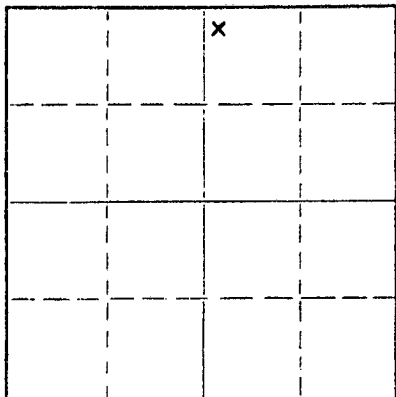

Locate well correctly on above
Section Plat

If a producing well is abandoned, date of last production _____ 19____
Was permission obtained from the Conservation Division or its agents before plugging was commenced? yes

Name of Conservation Agent who supervised plugging of this well Paul Turpin
Producing formation _____ Depth to top _____ Bottom _____ Total Depth of Well 2807 Feet
Show depth and thickness of all water, oil and gas formations.

OIL, GAS OR WATER RECORDS

CASING RECORD

| FORMATION | CONTENT | FROM | TO | SIZE | PUT IN | PULLED OUT |
|--|---------|------|----|--------|--------|------------|
| | | | | 10 3/4 | 200' | none |
| | | | | 5 1/2 | 2792' | 2490' |
| <p>RECEIVED STATE CORPORATION COMMISSION 8-12-66 AUG 12 1966</p> | | | | | | |

Describe in detail the manner in which the well was plugged, indicating where the mud fluid was placed and the method or methods used in introducing it into the hole. If cement or other plugs were used, state the character of same and depth placed, from _____ feet to _____ feet for each plug set.

Fill hole with rock from 2807' to 2780' and dump 5 sacks of cement

Pull pipe

Set 15' rock bridge from 200' to 185' and dump 20 sacks of cement

Mud hole to 30' and dump 10 sacks of cement to surface

(If additional description is necessary, use BACK of this sheet)

Name of Plugging Contractor Flint Engineering and Const. Co.
Address 2375 W. Central El Dorado, Kansas

STATE OF Kansas, COUNTY OF Butler, ss.

_____, (employee of owner) or (owner or operator) of the above-described well, being first duly sworn on oath, says: That I have knowledge of the facts, statements, and matters herein contained and the log of the above-described well as filed and that the same are true and correct. So help me God.

(Signature) [Signature]

(Address) _____

SUBSCRIBED AND SWORN to before me this 10th day of August 1966

[Signature]
Notary Public.

My commission expires Sept. 27, 1967

16-26-3E

9


KANSAS GEOLOGICAL SOCIETY
 KANSAS WELL LOG BUREAU - KANSAS WELL SAMPLE BUREAU
 KANSAS GEOLOGICAL SOCIETY BUILDING
 508 EAST MURDOCK - WICHITA, KANSAS

COMPANY SeRoBee Drilling Co., Inc. ✓
 FARM Blue NO. 1

SEC. 16 T. 26 R. 3E
 LOC. NW NW NE

TOTAL DEPTH 2807
 COMM. 5-23-55 COMP. 5-30-66
 SHOT OR TREATED
 CONTRACTOR SeRoBee Drilling Co., Inc.
 ISSUED

COUNTY Butler

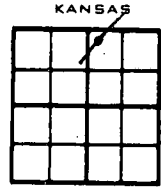

CASING
 20 10 200' W/200 SX
 15 8
 12 6
 13 5 1/2 - 2792' W/60 SX

ELEVATION 1355 KB

PRODUCTION

FIGURES INDICATE BOTTOM OF FORMATIONS

| | |
|-------------|----------------------|
| 0 - 20 | Shale |
| 20 - 65 | Sand |
| 65 - 200 | Hard Lime |
| 200 - 815 | Lime & Shale |
| 815 - 1335 | Shale & Lime Streaks |
| 1335 - 2130 | Lime & Shale |
| 2130 - 2215 | Lime |
| 2215 - 2410 | Lime & Shale |
| 2410 - 2450 | Lime |
| 2450 - 2786 | Lime & Shale |
| 2786 - 2807 | Miss. |

RECEIVED
 STATE CORPORATION COMMISSION
 JUN 10 1966
 CONSERVATION DIVISION
 Wichita, Kansas

Geological Tops

| | |
|---------------|--------------|
| Kansas City | 2331 (-976) |
| Base-K C | 2494 (-1039) |
| Cherokee | 2717 (-1362) |
| Conglomerate | 2774 (-1419) |
| Mississippian | 2786 (-1431) |
| Total Depth | 2807 (-1452) |

I certify the above to be a true and correct copy of the Driller's log and the geological tops to the best of my knowledge and belief.

SEROBEE DRILLING CO., INC.
Paul S. Septer
 Paul, S. Septer, President