


STATE OF KANSAS
STATE CORPORATION COMMISSION

Form CP-4

Give All Information Completely
Make Required Affidavit
Mail or Deliver Report to:
Conservation Division
State Corporation Commission
212 No. Market
Wichita, Kansas 67202

WELL PLUGGING RECORD

Graham County. Sec. 2 Twp. 10 Rge. 24 (E) (W) (W)
Location as "NE/CNW/SW" or footage from lines NE (SW) NW
Lease Owner Don E. Pratt Oil Operations
Lease Name O. Nickelson Well No. 4
Office Address Drawer 370 Hays, Kansas
Character of Well (completed as Oil, Gas or Dry Hole) Dry Hole
Date well completed September 16 19 71
Application for plugging filed September 16 19 71
Application for plugging approved September 16 19 71
Plugging commenced September 16 19 71
Plugging completed September 16 19 71
Reason for abandonment of well or producing formation Dry Hole
If a producing well is abandoned, date of last production _____ 19 ____
Was permission obtained from the Conservation Division or its agents before plugging was commenced? yes

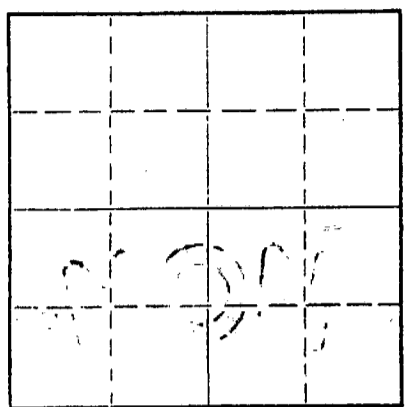

Locate well correctly on above Section Plat

Name of Conservation Agent who supervised plugging of this well Bill Nichols
Producing formation _____ Depth to top _____ Bottom _____ Total Depth of Well 4,045 Feet
Show depth and thickness of all water, oil and gas formations.

OIL, GAS OR WATER RECORDS

CASING RECORD

FORMATION	CONTENT	FROM	TO	SIZE	PUT IN	PULLED OUT
Surface Pipe		0	203	8 5/8		

Describe in detail the manner in which the well was plugged, indicating where the mud fluid was placed and the method or methods used in introducing it into the hole. If cement or other plugs were used, state the character of same and depth placed, from _____ feet to _____ feet for each plug set.

Pumped down hole with a pump truck with 5 sacks of hulls, 5 sacks of gel, 100 sacks of cement, 17 sacks of gel, released plug, mixed 25 sacks cement, 3 sacks gel, and 100 sacks of cement.


RECEIVED
STATE CORPORATION COMMISSION
SEP 24 1971
CONSERVATION DIVISION
Wichita, Kansas

(If additional description is necessary, use BACK of this sheet)
Name of Plugging Contractor Dreiling Oil, Inc.
Address R. R. # 2 Victoria, Kansas 67671

STATE OF Kansas, COUNTY OF Ellis, ss.
L. Leo F. Dreiling, Pres. of Drlg. Contr. (employee of owner) or (owner or operator) of the above-described well, being first duly sworn on oath, says: That I have knowledge of the facts, statements, and matters herein contained and the log of the above-described well as filed and that the same are true and correct. So help me God.

(Signature) Leo F. Dreiling
LEO F. DREILING, Route # 2 Victoria, Kansas
(Address) _____ 67671

SUBSCRIBED AND SWORN TO before me this 23rd day of September, 19 71

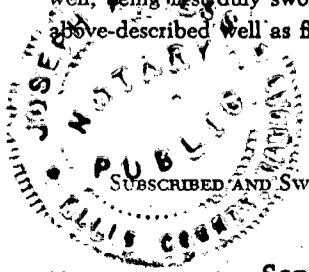

My commission expires September 19, 1974
Joseph A. Hess Notary Public.

