


WELL PLUGGING RECORD

Get All Information Completely
-ke Required Affidavit
-il or Deliver Report to:
Conservation Division
State Corporation Commission
211 No. Broadway
Wichita, Kansas

NORTH

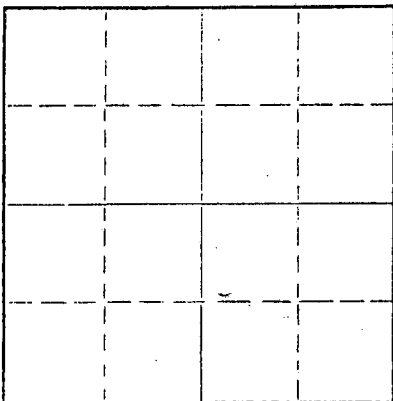

Locate well correctly on above
Section Plat

Graham County. Sec. 22 Twp. 10S Rge. 24W (X) (W)
Location as "NE/CNW/SW" or footage from lines C NW NE
Lease Owner Leben Drilling, Inc.
Lease Name Sproul Well No. 1
Office Address P. O. Box 486, Great Bend, Kansas
Character of Well (completed as Oil, Gas or Dry Hole) Dry Hole
Date well completed 11-23-63 19
Application for plugging filed 11-23-63 19
Application for plugging approved 11-23-63 19
Plugging commenced 11-23-63 19
Plugging completed 11-23-63 19
Reason for abandonment of well or producing formation Dry Hole

If a producing well is abandoned, date of last production _____ 19____
Was permission obtained from the Conservation Division or its agents before plugging was commenced? yes

Name of Conservation Agent who supervised plugging of this well Bill Nichols, Morland, Kansas
Producing formation _____ Depth to top _____ Bottom _____ Total Depth of Well 4030 Feet
Show depth and thickness of all water, oil and gas formations.

OIL, GAS OR WATER RECORDS

CASING RECORD

FORMATION	CONTENT	FROM	TO	SIZE	PUT IN	PULLED OUT
				8 5/8"	232'	none

Describe in detail the manner in which the well was plugged, indicating where the mud fluid was placed and the method or methods used in introducing it into the hole. If cement or other plugs were used, state the character of same and depth placed, from _____ feet to _____ feet for each plug set.

Mud to 550' Plug & 20 sacks cement

Mud to 220' Plug & 1/4 sack hulls & 20 sacks cement

Mud to 40' Plug & 1/2 sack hulls & 10 sacks cement
2 sacks in rathole

RECEIVED
STATE CORPORATION COMMISSION

NOV 26 1963

CONSERVATION DIVISION
Wichita, Kansas

(If additional description is necessary, use BACK of this sheet)

Name of Plugging Contractor Leben Drilling, Inc.
Address P. O. Box 486, Great Bend, Kansas

STATE OF KANSAS, COUNTY OF BARTON, ss.

Leslie Kite

(employee of owner) or (owner or operator) of the above-described well, being first duly sworn on oath, says: That I have knowledge of the facts, statements, and matters herein contained and the log of the above-described well as filed and that the same are true and correct. So help me God.

(Signature)

Leslie Kite

P. O. Box 486, Great Bend, Kansas
(Address)

SUBSCRIBED AND SWORN to before me this 25th day of November, 19 63

My commission expires April 1, 1967

Ulanda Nichols
Ulanda Nichols

Notary Public.



DRILLER'S LOG

COMPANY: Leben Drilling, Inc.
 CONTRACTOR: LEBEN DRILLING, INC.
 FARM: SPROUL #1
 LOCATION: C NW NE Sec. 22-10S-24W
 GRAHAM COUNTY, KANSAS
 COMMENCED: 11-11-63
 COMPLETED: 11-23-63

KB-2454

0	710	Shale
710	1655	Shale, Sand, Redbed
1655	2084	Sand, Shale
2084	2116	Anhydrite
2116	2590	Shale
2590	2795	Shale & Lime
2795	2930	Lime
2930	3340	Lime & Shale
3340	4030	Lime
	<u>4030</u>	<u>Rotary Total Depth - D & A.</u>

Set 8 5/8" used Surface Casing @ 232' Cemented with 175 sacks Sunset.

I, Leslie Kite, do hereby certify that the above and foregoing is a true and correct copy of the log of the Sproul #1 well, located Center Northwest Northeast (C NW NE) of Section 22, Township 10 South, and Range 24 West, Graham County, Kansas, as reflected by the files of Leben Drilling, Inc.

Leslie Kite

Leslie Kite

STATE OF KANSAS)
) SS
COUNTY OF BARTON)

Subscribed and sworn to before me, a Notary Public, in and for Barton County, Kansas, this 25th day of November, 1963.

Ulanda Nichols

Ulanda Nichols, Notary Public



My Commission Expires: April 1, 1967

RECEIVED
STATE CORPORATION COMMISSION
NOV 26 1963
CONSERVATION DIVISION
Wichita, Kansas