


STATE OF KANSAS
STATE CORPORATION COMMISSION

Give All Information Completely
Make Required Affidavit
Mail or Deliver Report to:
Conservation Division
State Corporation Commission
800 Bitting Building
Wichita, Kansas

WELL PLUGGING RECORD

Graham County. Sec. 4 Twp. 9S Rge. 23W (E) (W)
Location as "NE/CNW $\frac{1}{4}$ /SW $\frac{1}{4}$ " or footage from lines NE NE SE
Lease Owner C-G DRILLING CO. Inc.
Lease Name McPherson Well No. 1
Office Address 206 Union Nat'l Bank Bldg.
Character of Well (completed as Oil, Gas or Dry Hole) Dry Hole
Date well completed August 5 19 50
Application for plugging filed August 4 19 50
Application for plugging approved August 4 19 50
Plugging commenced August 5 19 50
Plugging completed August 5 19 50
Reason for abandonment of well or producing formation Too Low structurally

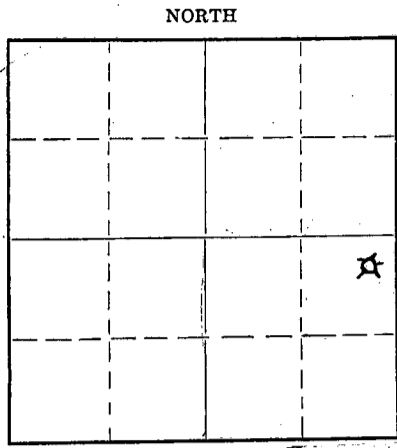

Locate well correctly on above
Section Flat

If a producing well is abandoned, date of last production _____ 19____
Was permission obtained from the Conservation Division or its agents before plugging was commenced? Yes

Name of Conservation Agent who supervised plugging of this well Eldon Petty, Hays, Kansas
Producing formation _____ Depth to top _____ Bottom _____ Total Depth of Well _____ Feet
Show depth and thickness of all water, oil and gas formations.


OIL, GAS OR WATER RECORDS

CASING RECORD

Formation	Content	From	To	Size	Put In	Pulled Out
				8-5/8" (28#)	255.57'	

Describe in detail the manner in which the well was plugged, indicating where the mud fluid was placed and the method or methods used in introducing it into the hole. If cement or other plugs were used, state the character of same and depth placed, from _____ feet to _____ feet for each plug set.

Filled with drilling mud to 253'. Drove plug to 250'
Put in 15 sacks cement then pumped full of mud 35' from
top of hole. Drove plug down to 35' then filled to top
with 10 sacks of cement.

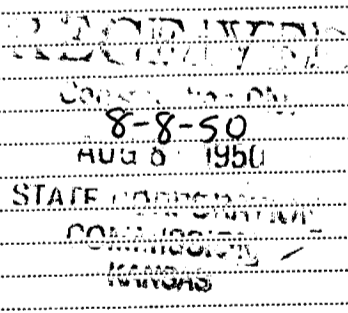


(If additional description is necessary, use BACK of this sheet)


Correspondence regarding this well should be addressed to C-G Drilling Co. Inc.
Address 206 Union National Bank Bldg., Wichita, Kansas

STATE OF Kansas, COUNTY OF Sedgwick, SS.
R. A. Cook (owner or operator) of the above-described well,
being first duly sworn on oath, says: That I have knowledge of the facts, statements, and matters herein contained and the log of the above-described well as filed and that the same are true and correct. So help me God.

(Signature) R A Cook
206 Union Natl Bank Bldg.
(Address)

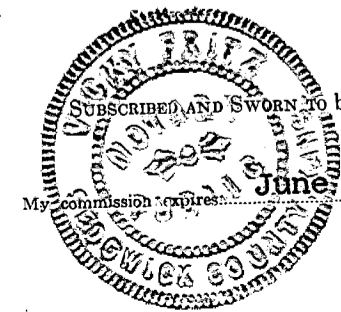

August 7th day of August, 19 50
Wicky Lutz
Notary Public.

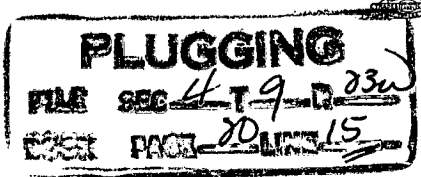

CONTRACTOR'S WELL LOG

Operator C-G DRILLING CO. Inc. Farm Name McPherson #1

Location NE NE SE Sec. 4-9S-23W

Pool Name W. C. County Graham State Kansas

Commencement Date July 24, 1950 Completion Date August 5, 1950

LOG OF WELL

Elevation 2237 D. F.
All Measurements from the top of rotary bushing.

DEPTH		FORMATION	DEVIATION FROM VERTICAL	REMARKS:
FROM	TO			
0	255			
255	700	Shale		
700	965	Shale-Shells		
965	1180	Sand-Shale		
1180	1300	Shale-Shells		
1300	1425	RedBed		
1425	1635	Sand	1500 -0°	
1635	1650	Shale-Shells		
1650	1700	Shale-Shells		
1700	1885	Shale-RedBed		
1885	1920	Anhydrate		
1920	2065	Shale-Shells	2000 -0°	
2065	2300	Shale-Shells		
2300	2425	Shale		
2425	2615	Shale	2500 -0°	
2615	2690	Shale		
2690	2870	Shale		
2870	2950	Shale-Lime		
2950	3050	Shale-Lime	3000 -0°	
3050	3130	Shale-Lime		
3130	3300	Shale		
3300	3380	Shale-Lime		
3380	3450	Lime		
3450	3490	Lime		
3490	3575	Lime		
3575	3630	Lime		
3630	3652	Lime		
3652	3710	Lime		
3710	3760	Lime		
3760	3785	Lime		
3785	3860	Shale-Lime		
3860	3909	Shale-Lime		
3909	3935	Shale-Lime		
3935	3985	Shale		
3985	4043	Shale-Lime		
4043	4095	Shale-Lime		

CASING LEFT IN HOLE AFTER COMPLETION

Ran 255.57' (8 Jts.) 8 5/8" OD Casing.

STATE OF KANSAS, COUNTY OF SEDGWICK) ss

The undersigned certifies that to the best of his knowledge and belief, the above facts are true and correct.

PLUGGING


Subscribed and sworn to before me this 7th day of August, 1950.
My commission expires:
June 25, 1951

C-G DRILLING CO. Inc.

By R. D. Cook
President

Vicki Lutz
Notary Public