

STATE OF KANSAS
STATE CORPORATION COMMISSION

WELL PLUGGING RECORD

Give All Information Completely
Make Required Affidavit
Mail or Deliver Report to
Conservation Division
State Corporation Comm.
245 North Water
Wichita, KS 67202

Graham County, Sec. 5 Twp. 9S Rge. 23 E/W
Location as "NE/CNW/SW" or footage from lines
NW NW NE


Lease Owner, Murfin Drilling Company
Lease Name Fountain "A" Well No. 1
Office Address 250 N. Water, Suite 300; Wichita, KS 67202
Character of Well (Completed as Oil, Gas or Dry Hole)
Oil

Date Well completed Jan. 2 19 58
Application for plugging filed -- 19 --
Application for plugging approved verbal 19 --
Plugging commenced Aug. 23 19 84
Plugging completed Aug. 23 19 84
Reason for abandonment of well or producing formation
uneconomical

If a producing well is abandoned, date of last production
Nov. 19 81

Was permission obtained from the Conservation Division or
its agents before plugging was commenced? Yes

Name of Conservation Agent who supervised plugging of this well Carl Goodrow
Producing formation LKC Depth to top 3640' Bottom 3857' Total Depth of Well 3870'
Show depth and thickness of all water, oil and gas formations.

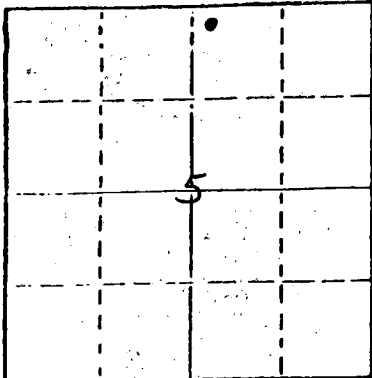

Locate well correctly on above
Section Plat

OIL, GAS OR WATER RECORDS

CASING RECORD

FORMATION	CONTENT	FROM	TO	SIZE	PUT IN	PULLED OUT
				8 5/8"	226'	--
				5 1/2"	3869'	--

Describe in detail the manner in which the well was plugged, indicating where the mud fluid
was placed and the method or methods used in introducing it into the hold. If cement or other
plugs were used, state the character of same and depth placed, from _____ feet to
_____ feet for each plug set.

Mixed and pumped down 5 1/2" casing: 50 sx. cement w/2 sx. gel and 3 sx hulls,
followed by 8 sx. gel. Released plug and pumped 30 sx. cement at 1300#. Max. press.
Pumped 50 sx. cement down 8 5/8" and 5 1/2" annulus at 250# max. press.

(If additional description is necessary, use BACK of this sheet)

Name of Plugging Contractor Murfin Drilling Company

STATE OF Kansas COUNTY OF Sedgwick, ss.
P. T. Canaday, Jr. Engineer (employee of owner) or (owner or operator)
of the above-described well, being first duly sworn on oath, says: That I have knowledge of
the facts, statements, and matters herein contained and the log of the above-described well
as filed and that the same are true and correct. So help me God.

(Signature) By: P. T. Canaday, Jr.
P. T. Canaday, Jr. Engineer, 250 N. Water
(Address) Wichita, KS 67202

SUBSCRIBED AND SWORN TO before me this 14 day of September, 19 84
KERRAN REDINGTON
NOTARY PUBLIC
STATE OF KANSAS
My Appt. Exp. 2-6-86
My commission expires 2/6/86
Kerran Redington
Notary Public.

RECEIVED
STATE CORPORATION COMMISSION

SEP 17 1984
9-17-84
CONSERVATION DIVISION
Wichita, Kansas