


STATE OF KANSAS
STATE CORPORATION COMMISSION

Give All Information Completely
Make Required Affidavit
Mail or Deliver Report to:
Conservation Division
State Corporation Commission
211 No. Broadway
Wichita, Kansas

WELL PLUGGING RECORD

NORTH

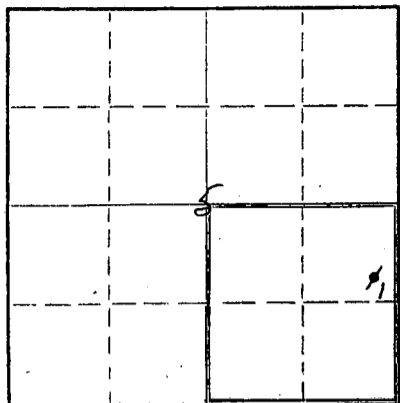

Locate well correctly on above
Section Plat

Graham County. Sec. 5 Twp. 9S Rge. (E) 23 (W)
Location as "NE/CNW*SW*" or footage from lines SE/4 NE/4 SE/4
Lease Owner Skelly Oil Company
Lease Name F. L. Jones Well No. 1
Office Address P. O. Box 1650, Tulsa, Oklahoma
Character of Well (completed as Oil, Gas or Dry Hole) Dry Hole
Date well completed March 5, 19 58
Application for plugging filed March 6, 19 58
Application for plugging approved March 7, 19 58
Plugging commenced March 7, 19 58
Plugging completed March 7, 19 58
Reason for abandonment of well or producing formation Dry Hole

If a producing well is abandoned, date of last production _____ 19____
Was permission obtained from the Conservation Division or its agents before plugging was commenced? Yes

Name of Conservation Agent who supervised plugging of this well Mr. A. D. Fabricius
Producing formation _____ Depth to top _____ Bottom _____ Total Depth of Well 3800 Feet
Show depth and thickness of all water, oil and gas formations.

OIL, GAS OR WATER RECORDS

CASING RECORD

FORMATION	CONTENT	FROM	TO	SIZE	PUT IN	PULLED OUT
Base Kans. City	Dry	3794'	3800'	8-5/8"	828'0"	None

Describe in detail the manner in which the well was plugged, indicating where the mud fluid was placed and the method or methods used in introducing it into the hole. If cement or other plugs were used, state the character of same and depth placed, from _____ feet to _____ feet for each plug set.

25 sacks of cement	3800' to 3725'
Heavy mud	3725' to 835'
25 sacks of cement	835' to 755'
Heavy mud	755' to 75'
25 sacks of cement	75' to 6'
Surface soil	6' to 0'

(If additional description is necessary, use BACK of this sheet)

Name of Plugging Contractor Claude Wentworth Drilling Co., Inc.
Address 2701 East 15th, Tulsa, Oklahoma

STATE OF Kansas, COUNTY OF Reno, ss.
H. E. Wamsley (employee of owner) or owner or operator of the above-described well, being first duly sworn on oath, says: That I have knowledge of the facts, statements, and matters herein contained and the log of the above-described well as filed and that the same are true and correct. So help me God.

(Signature) _____
Box 391, Hutchinson, Kansas
(Address)


SUBSCRIBED AND SWORN to before me this 18th day of March, 19 58
My commission expires April 7, 1959
Josephine L. Johnson Notary Public.

RECEIVED
STATE CORPORATION COMMISSION
MAR 19 1958
3-19-58
CONSERVATION DIVISION
Wichita, Kansas

PLUGGING
FILE SEC. 5 19 R234
87 16

SKELLY OIL COMPANY

Well Record

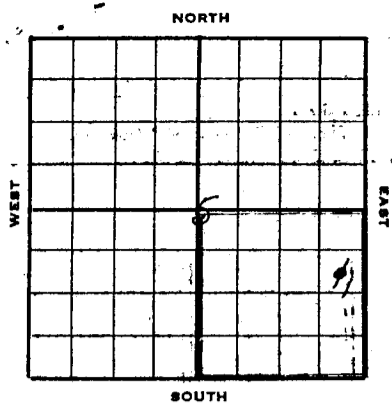

Lease Name and No. T. L. Jones Well No. 1 Elev. 2259' DF
 Lease Description SE/4 Sec. 5-9S-23W, Graham County,
Kansas (160 Acres)
 Location made Feb. 13, 1958 by T. J. Jussen
990 feet from North line 330 feet from East line SE/4
 feet from South line feet from West line of Sec. 5

Work com'd. 2/21 1958 Rig comp'd. 2/22 1958 Drlg. com'd. 2/22 1958 Drlg. comp'd. 3/3 1958
 Rig Contractor Claude Wentworth Drlg. Co., Inc.
 Drilling Contractor Claude Wentworth Drlg. Co., Inc., Tulsa, Oklahoma
 Rotary Drilling from 0' to 3800' Cable Tool Drilling from to

Commenced Producing DRY HOLE 19
 Initial Prod. before shot or acid Bbls.
 Initial Prod. after shot or acid Bbls.
 Dry Gas Well Press. Volume Cu. ft.
 Casing Head Gas Pressure Volume Cu. ft.
 Braden Head (Size) Gas Pressure Volume Cu. ft.
 Braden Head (Size) Gas Pressure Volume Cu. ft.

PRODUCING FORMATION DRY HOLE (Name) Top Bottom TOTAL DEPTH 3800'

CASING RECORD

OD	Size	Wt.	Thds.	Where Set	PULLED OUT			LEFT IN			KIND	Cond'n	CEMENTING	
					Jts.	Feet	In.	Jts.	Feet	In.			Sacks Used	Method Employed
8-5/8"	22.7	61	835'				21	828	0	Arco SW	A	475	Halliburton	

Liner Set at Length Perforated at
 Liner Set at Length Perforated at
 Packer Set at Size and Kind
 Packer Set at Size and Kind

SHOT OR ACID TREATMENT RECORD

	FIRST	SECOND	THIRD	FOURTH
Date				
Acid Used				
Size Shot				
Shot Between	Ft. and Ft.	Ft. and Ft.	Ft. and Ft.	Ft. and Ft.
Size of Shell				
Put in by (Co.)				
Length anchor				
Distance below Cas'g				
Damage to Casing or Casing Shoulder				

SIGNIFICANT GEOLOGICAL FORMATIONS

NAME	Top	Bottom	GAS		OIL		REMARKS
			From	To	From	To	
Opoka Line	3330'						
Heebner Shale	3541'						
Toronto Line	3566'						
Lansing Line	3582'						
Base Kans. City	3794'						

CLEANING OUT RECORDS

	DATE COMMENCED	DATE COMPLETED	PROD. BEFORE	PROD. AFTER	REMARKS
1st					See Reverse for other details.
2nd					" " " " "
3rd					" " " " "
4th					" " " " "

PLUGGING BACK AND DEEPENING RECORDS

	Date Commenced	Date Completed	No. Feet Plugged Back or Deepened	Prod. Before	Prod. After	REMARKS
1st						See Reverse for other details.
2nd						" " " " "
3rd						" " " " "
4th						" " " " "

(See Reverse for Record of Formation)

RECORD OF FORMATIONS

FORMATION	TOP	BOTTOM	REMARKS Indicate Casing Points, Describe Shows of Oil, Gas and Water, etc.
Surface soil and sand	0	150	
Sand and shale	150	500	
Sand	500	820	
Shale	820	835	Oil and cemented 8-5/8" OD, 22.7, Arco S.S., S.J. steel casing (A cord.) at 835' with 475 sacks of special oil well cement. Cement did not circulate. Finished cementing at 7:30 a.m. 2/23/58. Welox temperature survey showed top of cement behind 8-5/8" casing 21' from top.
Shale	835	935	
Shale, shells and sand	935	900	
shaly shale	1900	1938	
Shale and shells	1938	2300	
Shale and lime	2300	3047	TOP OVERS LINE 1330' TOP HILLMAN SHALE 3541' TOP KANSAS SHALE 3582' TOP LANSING LIMESTONE 3582'
White, fine crystalline lime	3047	3080	Dark oil stain, poor to fair waxy porosity
lime	3080	3083	
Light coarse lime	3083	3075	Fair inner-crystalline porosity, light to dark oil stain
lime	3075	3700	
White lime	3700	3716	Fine crystalline waxy porosity with dark oil stain
lime	3716	3718	
Hard, crystalline lime	3718	3730	Poor porosity, light oil stain with some calcareous chert
lime	3730	3732	
Dark Gray coarse, crystalline lime	3732	3742	Fair crystalline porosity, light oil stain
			Run Halliburton drill stem test No. 1, packer set at 3728', used 20' anchor, open 1 hour, weak blow for 20 mins., recovered 15' of drilling mud with few oil specks, no flow pressures, IFF-270 in 20 mins.
Green, fine crystalline lime, coarse	3742	3750	Light oil stain
lime	3750	3759	
Fine medium crystalline, cream lime	3759	3775	Fair inner-crystalline porosity, some light stain
			Run Halliburton drill stem test No. 2, packer set at 3747', used 20' anchor, open 1 hour, weak blow, recovered 35' of slightly oil and gas and water, IFF-02, IFF-302, IFF-1040 in 20 mins. 48.
Fine crystalline, cream lime	3775	3780	Fair inner-crystalline porosity, dark oil stain
lime	3780	3787	
Fine crystalline, cream lime	3787	3796	Fair inner-crystalline porosity, trace of free oil, some calcareous porosity
lime	3796	3800	BASE KANSAS SHALE LINE 3794' Run Halliburton drill stem test No. 3, packer set at 3775', used 25' anchor, open 1 hour, weak blow for 13 mins., recovered 12' of mud with few specks of oil, all pressures 0.
			Run Halliburton drill stem test No. 4 with spraddle packers, set top packer at 3740', bottom packer at 3720', used 72' anchor, open 1 hour, good blow, recovered 1037' of salt water with slight smell of oil, IFF-302, IFF-1702, IFF-1220 in 20 mins.
			Run Welox Guard Log from 1800'

Ran Halliburton Drill stem test No. 5 with straddle packers, set top packer at 3600', bottom packer at 3638', used 162' anchor, open 1 hour, strong blow, recovered 994' of salt water, No oil, IFF-25, IFF-480, IFF-1285 in 20 minutes.

Since no commercial oil or gas production was encountered in drilling to the total depth of 3800', regular authority was granted to plug and abandon the well.

The well was plugged as follows:

25 sacks of cement	3800'	to	3725'
Heavy mud	3725'	to	835'
25 sacks of cement	835'	to	755'
Heavy mud	755'	to	75'
25 sacks of cement	75'	to	6'
Surface soil	6'	to	0'

Plugged and abandoned March 7, 1958.

<u>SLOPE TEST DATA</u>	
<u>DEPTH</u>	<u>ANGLE of DEFLECTION</u>
1000'	0 Degree
1500'	0 "
2000'	0 "
2380'	1/2 "
2600'	1/2 "
3500'	0 "

PLANNING
FIL SEC 5 79 22310
BOOK PAGE 87 III. 16