


STATE OF KANSAS
STATE CORPORATION COMMISSION

Give All Information Completely
Make Required Affidavit
Mail or Deliver Report to:
Conservation Division
State Corporation Commission
211 No. Broadway
Wichita, Kansas

WELL PLUGGING RECORD

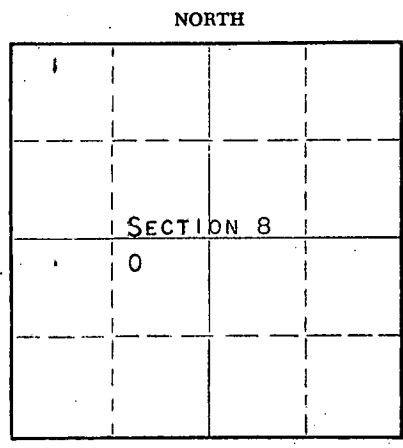

Locate well correctly on above Section Plat

GRAHAM County, Sec. 8 Twp. 9 Rge. 23 (W)
Location as "NE/CNWxSWx" or footage from lines NW NE SW
Lease Owner PETROLEUM, INC.
Lease Name STEWART "D" Well No. 1
Office Address ROUTE 2, GREAT BEND, KANSAS
Character of Well (completed as Oil, Gas or Dry Hole) DRY HOLE
Date well completed NOVEMBER 1 19 58
Application for plugging filed NOVEMBER 1 19 58
Application for plugging approved NOVEMBER 1 19 58
Plugging commenced NOVEMBER 1 19 58
Plugging completed NOVEMBER 1 19 58
Reason for abandonment of well or producing formation NO PRODUCIBLE ZONES

If a producing well is abandoned, date of last production NONE 19
Was permission obtained from the Conservation Division or its agents before plugging was commenced? YES

Name of Conservation Agent who supervised plugging of this well A. D. FABRICIUS
Producing formation ----- Depth to top ----- Bottom ----- Total Depth of Well 3870 Feet
Show depth and thickness of all water, oil and gas formations.

OIL, GAS OR WATER RECORDS

CASING RECORD

FORMATION	CONTENT	FROM	TO	SIZE	PUT IN	PULLED OUT
				8-5/8"	250'	NONE

Describe in detail the manner in which the well was plugged, indicating where the mud fluid was placed and the method or methods used in introducing it into the hole. If cement or other plugs were used, state the character of same and depth placed, from _____ feet to _____ feet for each plug set.

MUD UP WITH HEAVY MUD TO 600' FOLLOWED BY A WOODEN PLUG. PLACED 20 SACKS CEMENT THROUGH DRILL PIPE ON TOP OF PLUG, MUD UP TO 256' FOLLOWED BY A WOODEN PLUG AND 1/3 SACK HULLS. PLACED 20 SACKS CEMENT THROUGH DRILL PIPE ON TOP OF PLUG. MUD UP TO 40' FOLLOWED BY A WOODEN PLUG AND 1/3 SACK HULLS. FILLED HOLE TO BASE OF WELL CELLAR WITH 10 SACKS CEMENT.


STATE OF KANSAS
NOV 13 1958
CONSERVATION DIVISION
WICHITA, KANSAS

(If additional description is necessary, use BACK of this sheet)
Name of Plugging Contractor GARVEY DRILLING COMPANY
Address ROUTE 2, GREAT BEND, KANSAS

STATE OF KANSAS, COUNTY OF BARTON, ss.
DON SEARLE (employee of owner) or (owner) of the above-described well, being first duly sworn on oath, says: That I have knowledge of the facts, statements, and matters herein contained and the log of the above-described well as filed and that the same are true and correct. So help me God.

(Signature) Don Searle
ROUTE 2, GREAT BEND, KANSAS
(Address)

SUBSCRIBED AND SWORN to before me this 12TH day of NOVEMBER 19 58
My commission expires JULY 11, 1960
Notary Public.

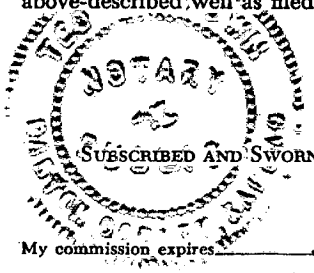

PLUGGING
FILE SEC. 8 T. 9 R. 23W
BOOK PAGE 141 LINE 27

WELL LOG

COMPANY PETROLEUM, INCORPORATED

SEC. 8 T. 9S R. 23W

FARM STEWART "D" NO. 1


LOC. NW, NE, SW

TOTAL DEPTH 3870'

COUNTY GRAHAM CO., KANSAS

COMM. October 24, 1958 COMP. November 1, 1958

CONTRACTOR GARVEY DRILLING COMPANY

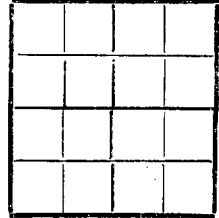

CASING 8 5/8" @ 256' W/175 sax.

ELEVATION 2295' DF

PRODUCTION D & A

FIGURES INDICATE BOTTOM OF FORMATIONS

35	v	Surface sand
100		Clay & blue shale
256		Blue shale
500		Shale
700		Shale & sand
1000		Sand
1720		Shale & sand
1935		Shale
1985		Anhydrite
2635		Shale & lime
2865		Shale
3190		Shale & lime
3650		Lime & shale
3862		Lime
3870		Lime & shale
3870		T. D.

RECEIVED
STATE CORPORATION COMMISSION

NOV 13 1958

CONSERVATION DIVISION
Wichita, Kansas

PLUGGING
 FILE SEC. 8 T. 9 R. 23W
 BOOK PAGE 141 LINE 27

State of KANSAS
County of BARTON

ss:

I, VERNE A. MORRIS of GARVEY DRILLING COMPANY

upon oath state that the above and foregoing is a true and correct copy of the log of the #1 STEWART "D" well

Subscribed and sworn to before me this 11th day of November 19 58

My Commission Expires: July 11, 1960

Verne A. Morris

Deed T. Brown

 NOTARY PUBLIC

