

STATE OF KANSAS
STATE CORPORATION COMMISSION
CONSERVATION DIVISION
P. O. BOX 17027
WICHITA, KANSAS 67217

FORM CP-4

WELL PLUGGING RECORD

Graham County, Sec. 9 Typ 9S Rge. 23 (X) (W)

Location as "NE/CNWKSW" or footage from lines: 430' FNL & 380' FEL

Lease Owner Cities Service Oil Company

Lease Name Brush Creek Well No. 306

Office Address 700 Sutton Place Bldg., 209 E. William, Wichita, Kans

Character of Well (completed as Oil, Gas or Dry Hole) Dry Hole

Date well completed 8-16 1975

Application for plugging filed 2-10 1976

Application for plugging approved 2-13 1976


Plugging commenced 3-1 1976

Plugging completed 3-1 1976

Reason for abandonment of well or producing formation Dry Hole

If a producing well is abandoned, date of last production 19

Was permission obtained from the Conservation Division or its agents before plugging was commenced? Yes

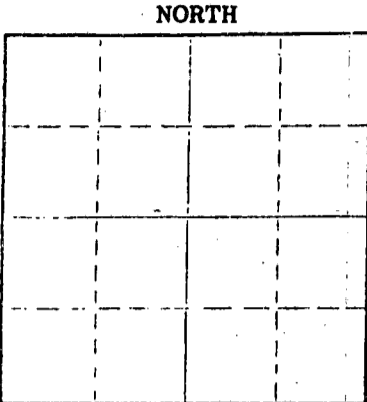

Locate well correctly on above Section Plat

Name of Conservation Agent who supervised plugging of this well Gilbert Balthazar

Producing formation Lansing-Kansas City Depth to top 3681 Bottom 3910 Total Depth of Well 3910

Show depth and thickness of all water, oil and gas formations.

OIL, GAS OR WATER RECORDS

CASING RECORD

FORMATION	CONTENT	FROM	TO	SIZE	PUT IN	PULLED OUT
				8-5/8"	207'	-0-

Describe in detail the manner in which the well was plugged, indicating where the mud fluid was placed and the method or methods used in introducing it into the hole. If cement or other plugs were used, state the character of same and depth placed, from feet to feet for each plug set.

Spot 65 sacks 50/50 Pozmix at 2230'. Spot 5 sacks hulls at 620'. Spot 130 sacks common cement from 500' to surface.

RECEIVED
STATE CORPORATION COMMISSION
5-11-76
MAY 11 1976

CONSERVATION DIVISION
Wichita, Kansas

Name of Plugging Contractor Allied Cementing Company

Address P. O. Box 31, Russell, Kansas 67665

STATE OF Kansas COUNTY OF Sedgwick
E.W. Peterman (employee of owner) or (owner)

will being first duly sworn on oath, say: That I have knowledge of the facts, statements, and matters herein contained and the log of the above-described well as filed and that the same are true and correct. So help me God.

Glenn E. Meier
STATE NOTARY PUBLIC
Sedgwick County, Kansas

(Signature) E.W. Peterman
700 Sutton Place Bldg., Wichita, Kansas
(Address)

Subscribed and sworn to before me this 6th day of May 1976

My commission expires 6-3-77
Glenn E. Meier Notary Public.

DRILLERS' WELL LOG

DATE COMMENCED: August 8, 1975
DATE COMPLETED: August 16, 1975

Cities Service Oil Co.
BRUSH CREEK TR. 3 # 6
NE NE NE of Sec. 9-T9S-R23W
Graham County, Kansas

ELEVATION: 2350 K.B.

0 - 207' Shale, Clay, Sand Streaks
207 - 870' Shale
870 - 1330' Shale w/Sand Streaks
1330 - 1670' Sand
1670 - 1995' Shale
1995 - 2028' Anhydrite
2028 - 3426' Shale and Lime
3426 - 3643' Lime
3643 - 3647' Shale
3647 - 3910' Lime and Shale
3910' RTD

FORMATION DATA

Anhydrite 1995
Topeka 3426
Heebner 3643
Toronto 3660
Lansing 3681
RTD 3910

SURFACE PIPE:

Set used, 8 5/8" @ 207' w/150
sacks of Class A cement, 3/4 cc.

Spot 65 sacks 50/50 Pozmix @
2230' - Temporary Abandon.

A F F I D A V I T

STATE OF KANSAS }
COUNTY OF BARTON } ss.

Wayne Dobbs, of lawful age, does swear and state that the facts and
statements herein contained are true and correct to the best of his knowledge.

Wayne Dobbs

Subscribed and sworn to before me this 28 day of August, 1975.

Harold M. Hague
Notary Public

My Commission Expires: April 11, 1978



RECEIVED
FEB 13 1976

FEB 13 1976
CONSERVATION, DIV. 5.311