

STATE OF KANSAS
STATE CORPORATION COMMISSION

WELL PLUGGING RECORD

Give All Information Completely
Make Required Affidavit
Mail or Deliver Report to:
Conservation Division
State Corporation Commission
211 No. Broadway
Wichita, Kansas

Graham County, Sec. 9 Twp. 9S Rge. 23W (E) (W)

Location as "NE/CNW&SW" or footage from lines SW SE NE

Lease Owner Imperial Oil of Kansas, Inc.

Lease Name Beiker "B" Well No. 5

Office Address Wichita, Kansas

Character of Well (completed as Oil, Gas or Dry Hole) Dry Hole

Date well completed November 5, 19 57

Application for plugging filed November 5, 19 57

Application for plugging approved November 5, 19 57


Plugging commenced November 5, 19 57

Plugging completed November 5, 19 57

Reason for abandonment of well or producing formation No commercial quantities of oil found.

If a producing well is abandoned, date of last production _____ 19 _____

Was permission obtained from the Conservation Division or its agents before plugging was commenced? Eldon Petty, Hays, Kansas

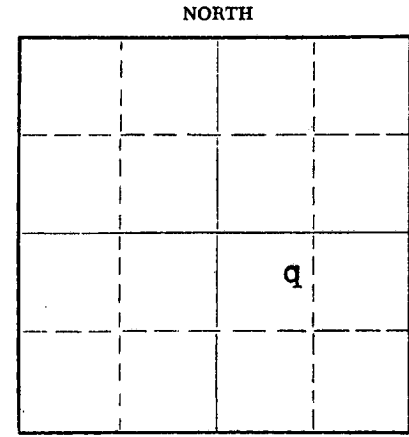

Locate well correctly on above Section Plat

Name of Conservation Agent who supervised plugging of this well _____

Producing formation _____ Depth to top _____ Bottom _____ Total Depth of Well 3891 Feet

Show depth and thickness of all water, oil and gas formations.

OIL, GAS OR WATER RECORDS

CASING RECORD

FORMATION	CONTENT	FROM	TO	SIZE	PUT IN	PULLED OUT
				8-5/8"	10-25-57	

Describe in detail the manner in which the well was plugged, indicating where the mud fluid was placed and the method or methods used in introducing it into the hole. If cement or other plugs were used, state the character of same and depth placed, from _____ feet to _____ feet for each plug set.

Plugged hole at 500 feet with 25 sacks cement, Set No. 2 plug at 215 feet with 20 sacks cement, Set No. 3 plug at 40 feet with 15 sacks cement.

RECEIVED
STATE CORPORATION COMMISSION

NOV 27 1957
11-27-57
CONSERVATION DIVISION
Wichita, Kansas

(If additional description is necessary, use BACK of this sheet)
Name of Plugging Contractor Imperial Oil of Kansas, Inc.
Address 780 Fourth National Bldg., Wichita 2, Kansas

STATE OF KANSAS, COUNTY OF SEDGWICK, ss.
Raymond L. Bacon (employee of owner) or (owner or operator) of the above-described well, being first duly sworn on oath, says: That I have knowledge of the facts, statements, and matters herein contained and the log of the above-described well as filed and that the same are true and correct. So help me God. IMPERIAL OIL OF KANSAS, INC.

(Signature) By: Ray L. Bacon V-P



SUBSCRIBED AND SWORN to before me this 26th day of November, 19 57
Luetta M. Aussen Notary Public.

PLUGGING
FILE SEC 9 T 9 R 23W
BOOK PAGE 60 LINE 36

DRILLER'S LOG

Imperial Oil of Kansas, Inc.
780 Fourth National Building
Wichita 2, Kansas

Beiker "B" No. 5
SW SE NE Sec. 9-9S-23W
Graham County, Kansas

Total Depth: 3891'

Commenced: 10-25-57 Completed: 11-5-57

Elevation: 2344' KB
Production: D & A

Contractor: Imperial Oil of Kansas, Inc.
Wichita 2, Kansas

Casing Record: Set 8-5/8" Surface Pipe at 217 feet with 1957 sacks cement.

Figures indicate bottom of formations:

Surface Clay & Sand	217'		<u>TOPS</u>	
Sand & Shale	1515'	Anhydrite	1990'	(/ 354)
Dakota Sand	1725'	Heebner	3637'	(-1293)
Shale & Red Bed	1990'	Toronto	3658'	(-1314)
Anhydrite	2033'	Lansing	3672'	(-1328)
Shale & Shells	2485'	Rotary Total Depth	3891'	(-1547)
Shale & Lime	3405'			
Lime	3891'			
Total Depth	3891'			

We hereby certify this to be a correct and accurate log of the above described well as shown on the daily drilling reports.

IMPERIAL OIL OF KANSAS, INC.

By: Ray L. Bacon
Vice-President



Subscribed and sworn to before me this 26th day of November, 1957.

RECEIVED
STATE CORPORATION COMMISSION

My Commission Expires:

December 19, 1960

NOV 27 1957

Loretta M. Durcan
Notary Public

CONSERVATION DIVISION
Wichita, Kansas

PLUGGING
FILE SEC 9 T 9 R 23W
BOOK PAGE 60 LINE 36