

WELL PLUGGING RECORD

Give All Information Completely  
Make Required Affidavit  
Mail or Deliver Report to:  
Conservation Division  
State Corporation Commission  
211 No. Broadway  
Wichita, Kansas

Graham County. Sec. 9 Twp. 9S Rge. XXXX 23 (W)

Location as "NE/CNW/SW" or footage from lines NW - SE - SE

Lease Owner Champlin Oil & Refining Co.

Lease Name Earl Radcliffe Well No. 3

Office Address P. O. Box 308, Ellinwood, Kansas.

Character of Well (completed as Oil, Gas or Dry Hole) Dry Hole

Date well completed August 15, 1963

Application for plugging filed August 15, 1963

Application for plugging approved August 16, 1963


Plugging commenced August 15, 1963

Plugging completed August 15, 1963

Reason for abandonment of well or producing formation \_\_\_\_\_

If a producing well is abandoned, date of last production \_\_\_\_\_ 19\_\_\_\_

Was permission obtained from the Conservation Division or its agents before plugging was commenced? Yes.

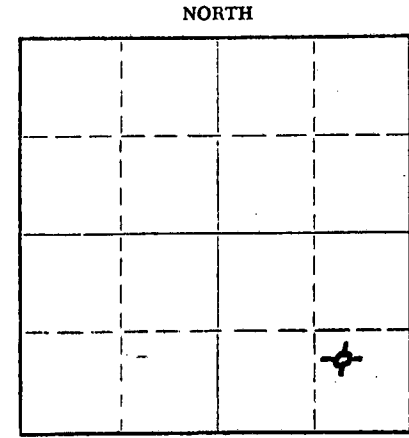

Locate well correctly on above Section Plat

Name of Conservation Agent who supervised plugging of this well W. L. Nichols, Moreland, Kansas.

Producing formation \_\_\_\_\_ Depth to top \_\_\_\_\_ Bottom \_\_\_\_\_ Total Depth of Well 3900 Feet

Show depth and thickness of all water, oil and gas formations.

OIL, GAS OR WATER RECORDS

CASING RECORD

FORMATION	CONTENT	FROM	TO	SIZE	PUT IN	PULLED OUT
				8 5/8" OD	265'	None

Describe in detail the manner in which the well was plugged, indicating where the mud fluid was placed and the method or methods used in introducing it into the hole. If cement or other plugs were used, state the character of same and depth placed, from \_\_\_\_\_ feet to \_\_\_\_\_ feet for each plug set.

Filled hole with heavy mud from 3900' TD to 540' and set plug using 1/2 sack of hulls and 20 sacks of cement then filled hole with mud to 250' and set plug using 1/2 sack of hulls and 20 sacks of cement then filled hole with mud to 40' and set plug filling hole to bottom of cellar using 10 sacks of cement.

RECEIVED  
STATE CORPORATION COMMISSION

AUG 21 1963  
8-21-63  
CONSERVATION DIVISION  
Wichita, Kansas

(If additional description is necessary, use BACK of this sheet)

Name of Plugging Contractor Red Tiger Drilling Company

Address 1720 Wichita Plaza, Wichita 2, Kansas

STATE OF Kansas, COUNTY OF Barton, ss.

J. W. Meyers (employee of owner) or (~~owner or operator~~) of the above-described

well, being first duly sworn on oath, says: That I have knowledge of the facts, statements, and matters herein contained and the log of the above-described well as filed and that the same are true and correct. So help me God.

(Signature) J. W. Meyers

P. O. Box 308, Ellinwood, Kansas.


(Address)

SUBSCRIBED AND SWORN to before me this 20th day of August, 1963.

N. Kenneth Starn

Notary Public.

My commission expires 5-22-66

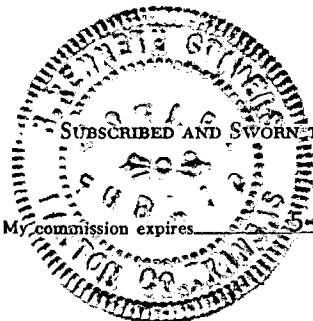

Champlin Oil & Refining Co.  
Earl Radcliffe #3  
NW-SE-SE Sec. 9-9S-23W  
Graham County, Kansas

Formation Log

0'	-	275'	Surface sand and shale
275'	-	1525'	Shale and shells
1525'	-	1730'	Sand
1730'	-	1845'	Shale and shells
1845'	-	1915'	Shale, shells and sand
1915'	-	2015'	Anhydrite
2015'	-	2345'	Red bed and shale
2345'	-	3555'	Lime and shale
3555'	-	3900'	Lime
3900'	-		Total Depth

**RECEIVED**  
STATE CORPORATION COMMISSION

AUG 21 1963

CONSERVATION DIVISION  
Wichita, Kansas