

WELL PLUGGING RECORD


FORMATION PLUGGING RECORD

STATE OF KANSAS
STATE CORPORATION COMMISSION

Give ALL Information Completely
Make Required Affidavit
Mail or Deliver Report to:
Conservation Division
State Corporation Commission
800 Biting Building
Wichita, Kansas

Strike out upper line
when reporting plug-
ging off formations.

Graham County. Sec. 11 Twp. 9 Rge. 23 (E) (W)
Location as "NE $\frac{1}{4}$ NW $\frac{1}{4}$ SW $\frac{1}{4}$ " or footage from lines. NE NE SE/4
Lease Owner. Virginia Drilling Co., Inc & Aladdin Petroleum
Lease Name. Casey Jones Well No. 1
Office Address. 701 Brown Bldg., Wichita 2, Kansas
Character of Well (completed as Oil, Gas or Dry Hole). Dry Hole
Date well completed. 8-13 1949
Application for plugging filed. 8-13 1949
Application for plugging approved. 8-13 1949
Plugging commenced. 8-13 1949
Plugging completed. 8-13 1949
Reason for abandonment of well or producing formation.

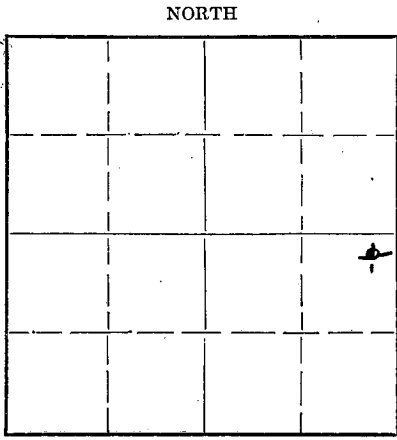

Locate well correctly on above
Section Plat

If a producing well is abandoned, date of last production. 19
Was permission obtained from the Conservation Division or its agents before plugging was com-
menced? yes

Name of Conservation Agent who supervised plugging of this well. C. D. Stough
Producing formation. Depth to top. Bottom. Total Depth of Well. 4125 Feet
Show depth and thickness of all water, oil and gas formations.

OIL, GAS OR WATER RECORDS

CASING RECORD

Formation	Content	From	To	Size	Put In	Pulled Out
		0	153	8-5/8"	152	none

Describe in detail the manner in which the well was plugged, indicating where the mud fluid was placed and the method or methods used in introducing it into the hole. If cement or other plugs were used, state the character of same and depth placed, from _____ feet to _____ feet for each plug set.

Filled hole with mud to 152 ft. Set wooden plug. Run 15 sacks cement.
Filled with mud to 25 ft. Run 10 sacks cement.


RECEIVED
Cons. Div.
8-22-49
AUG 22 1949
STATE CORPORATION
COMMISSION
KANSAS

(If additional description is necessary, use BACK of this sheet)

Correspondence regarding this well should be addressed to Virginia Drilling Company, Inc.
Address. 701 Brown Bldg., Wichita, Kansas

STATE OF Kansas, COUNTY OF Sedgewick, ss.
S. A. Murphy (employee of owner) or (owner or operator) of the above-described well,
being first duly sworn on oath, says: That I have knowledge of the facts, statements, and matters herein contained and the log of the above-
described well as filed and that the same are true and correct. So help me God.

(Signature) S. A. Murphy
701 Brown Bldg., Wichita, Kansas
(Address)

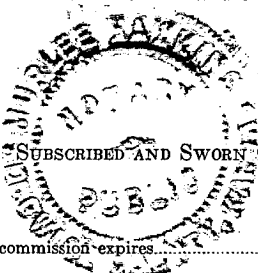

SUBSCRIBED AND SWORN to before me this 20th day of August, 1949
My commission expires Feb. 5, 1953
M. Lee Dawkins
Notary Public.

PLUGGING
FILE SEC-11 T-9 R-236
BOOK PAGE 110 LINE 10

Name: Casey Jones No. 1
 Location: NE NE SE Section 11-9S-23W, Graham County, Kansas
 Company: Virginia Drilling Company, Inc. & Aladdin Petroleum Corporation
 Contractor: Virginia Drilling Company, Inc.
 Commenced: July 30, 1949
 Completed: August 14, 1949
 Elevation: 2351
 Total Depth: 4125'

FORMATION	DEPTH	TOPS:
Shale	0-460	Toronto 3625
Shale-shells	460-940	Kansas City 3645
Shale-sand	940-1220	Marmaton 3868
Sand	1220-1300	Marmaton Chert 3962
Shale	1300-1400	Penn. Cherty Conglomerate 4034
Sand	1400-1690	Arbuckle 4097
Shale	1690-1900	
Lime-shale	1900-2060	8-5/8" csg. set @ 153
Shale-lime streaks	2060-2180	
Lime	2180-2540	
Lime-shale	2540-2755	
Lime	2755-2975	
Lime-shale	2975-3048	
Lime	3048-3605	
Shale-lime	3605-3675	
Lime	3675-3908	
Lime-shale	3908-3939	
Lime	3939-4125	

Now comes S. A. Murphy, who states that he is familiar with the drilling of oil and gas wells and knows of his own knowledge that the Casey Jones No. 1, located in the NE NE SE Section 11-9S-23W, Graham County, Kansas was drilled to a total depth of 4125 feet. Same was plugged and abandoned.

Subscribed and sworn to before me this 20th day of August, 1949.

S. A. Murphy

Charles Edwin King
 Notary Public



AUG 22 1949
 COMMISSION
 KANSAS

PLUGGING
 FILE SEC 11 T 9 R 23W
 BOOK PAGE 110 LINE 10