

STATE OF KANSAS  
STATE CORPORATION COMMISSION

15-065-20404-00-00


Form CP-4

Give All Information Completely  
Make Required Affidavit  
Mail or Deliver Report to:  
Conservation Division  
State Corporation Commission  
212 No. Market  
Wichita, Kansas 67202

WELL PLUGGING RECORD

Graham County, Sec. 4 Twp. 10S Rge. (E) 22 (W)  
Location as "NE/CNW/SW" or footage from lines SW NE NE  
Lease Owner Beacon Resources Corporation  
Lease Name McElroy Well No. 1  
Office Address 1000 Century Plaza, Wichita, Kansas  
Character of Well (completed as Oil, Gas or Dry Hole) Dry Hole  
Date well completed January 5, 1971  
Application for plugging filed 19  
Application for plugging approved 19  
Plugging commenced January 5, 1971  
Plugging completed January 5, 1971  
Reason for abandonment of well or producing formation Dry Hole

If a producing well is abandoned, date of last production 19  
Was permission obtained from the Conservation Division or its agents before plugging was commenced? Yes (W. L. Nichols of Morland)

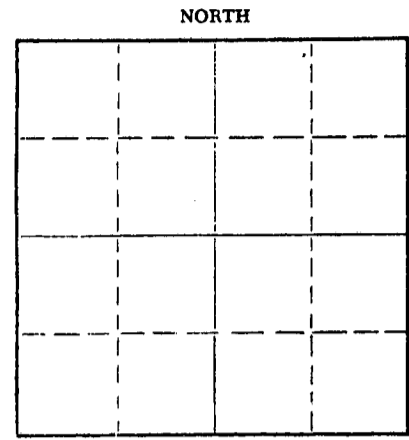

Locate well correctly on above Section Plat

Name of Conservation Agent who supervised plugging of this well  
Producing formation Depth to top Bottom Total Depth of Well 3860 Feet  
Show depth and thickness of all water, oil and gas formations.

OIL, GAS OR WATER RECORDS				CASING RECORD		
FORMATION	CONTENT	FROM	TO	SIZE	PUT IN	PULLED OUT
	Surface Casing	0	250'	8-5/8"	250'	-----

Describe in detail the manner in which the well was plugged, indicating where the mud fluid was placed and the method or methods used in introducing it into the hole. If cement or other plugs were used, state the character of same and depth placed, from feet to feet for each plug set.

Heavy Mud from Total Depth to 985 Feet,  
Plug and 70 sax Cement; Mud to 275 Feet,  
Plug and 20 sax Cement; Mud to 40 Feet,  
1/2 sax Hulls, Plug bridged w/Kelly and  
10 sax Cement to Base of Cellar. 2 sax  
Cement in Rat Hole. Job Completed @  
2 P.M. by Globe.

RECEIVED  
STATE CORPORATION COMMISSION  
JAN 7 1971  
CONSERVATION DIVISION  
Wichita, Kansas  
01-07-1971

(If additional description is necessary, use BACK of this sheet)  
Name of Plugging Contractor Globe Oilwell Cementing, Inc.  
Address Box 628, Great Bend, Kansas 67530

STATE OF KANSAS, COUNTY OF SEDGWICK, ss.  
Clarence Michael of Sage Drilling Co. (employee or owner or (owner or operator) of the above described

well being first duly sworn on oath, says: That I have knowledge of the facts, statements, and matters herein contained and the log of the above-described well as filled and that the same are true and correct. So help me God.

(Signature) Clarence Michael  
500 Bitting Bldg., Wichita, Kansas  
(Address)

Subscribed and Sworn to before me this 6th day of January, 1971



Louise K. Whitted  
Louise K. Whitted = Notary Public.

My commission expires November 26, 1974.

15-065-20404-00-00

DRILLERS LOG

McELROY NO. 1

CASING RECORD:	OPERATOR: Beacon Resources Corp.	DESCRIPTION:
8-5/8" @ 250' w/185 sax cement	CONTRACTOR: Sage Drilling Co., Inc.	SW NE NE Sec. 4-10S-22W Graham County, Kansas
TOTAL DEPTH: 3860'	COMMENCED: December 23, 1970	
	COMPLETED: January 5, 1971	

<u>FORMATION</u>	<u>FROM</u>	<u>TO</u>	<u>REMARKS</u>
Top Soil & Shale	0	252	
Sand & Shale	252	400	
Shale	400	1030	
Shale & Sand	1030	1642	
Shale	1642	1874	
Anhydrite	1874	1912	
Shale & Shells	1912	1915	
Shale & Lime	1915	2720	
Lime & Shale	2720	3604	
Lime	3604	3860	D&A

RECEIVED  
STATE CORPORATION COMMISSION  
JAN 7 1971  
CONSERVATION DIVISION  
Wichita, Kansas  
01-07-1971

I certify that this is a true and correct copy of the above log to the best of my knowledge.

SAGE DRILLING CO., INC.

By Clarence Michael  
Clarence Michael



Subscribed and sworn to before me this 5th day of January, 1971.

Louise K. Whitted  
Louise K. Whitted, Notary Public

My commission expires:  
November 26, 1974.