


WELL PLUGGING RECORD

Give All Information Completely  
Make Required Affidavit  
Mail or Deliver Report to:  
Conservation Division  
State Corporation Commission  
211 No. Broadway  
Wichita, Kansas

NORTH

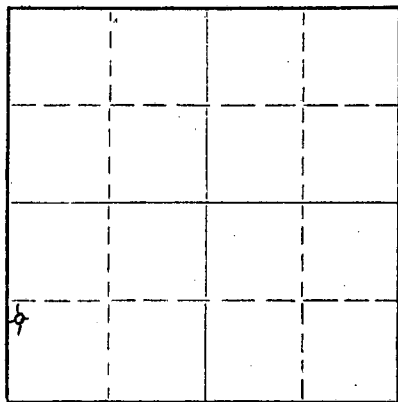

Locate well correctly on above  
Section Plat

Graham County. Sec. 5 Twp. 10S Rge. (E) 22 (W)  
Location as "NE/CNW/SW" or footage from lines SW SW NW  
Lease Owner Transit Corporation  
Lease Name Sandlin Well No. 1  
Office Address 1516 Liberty Bank Building, Okla. City, Okla.  
Character of Well (completed as Oil, Gas or Dry Hole) Dry Hole  
Date well completed August 14, 1957 19.  
Application for plugging filed " 19.  
Application for plugging approved " 19.  
Plugging commenced " 19.  
Plugging completed " 19.  
Reason for abandonment of well or producing formation \_\_\_\_\_

If a producing well is abandoned, date of last production \_\_\_\_\_ 19.  
Was permission obtained from the Conservation Division or its agents before plugging was commenced? Yes

Name of Conservation Agent who supervised plugging of this well Eldon Petty, Box 326, Hays, Kansas  
Producing formation \_\_\_\_\_ Depth to top \_\_\_\_\_ Bottom \_\_\_\_\_ Total Depth of Well \_\_\_\_\_ Feet  
Show depth and thickness of all water, oil and gas formations.

OIL, GAS OR WATER RECORDS

CASING RECORD

FORMATION	CONTENT	FROM	TO	SIZE	PUT IN	PULLED OUT
				8 5/8"	189'	None

Describe in detail the manner in which the well was plugged, indicating where the mud fluid was placed and the method or methods used in introducing it into the hole. If cement or other plugs were used, state the character of same and depth placed, from \_\_\_\_\_ feet to \_\_\_\_\_ feet for each plug set.

Filled with heavy drilling mud to 650', set plug and cemented with 20 sacks; Filled hole with heavy drilling mud to 175', cemented with 15 sacks; Filled hole with heavy drilling mud to 40' set plug and cemented to bottom of cellar with 10 sacks.

(If additional description is necessary, use BACK of this sheet)

Name of Plugging Contractor Transit Corporation  
Address 1516 Liberty Bank Building, Oklahoma City, Oklahoma

STATE OF Oklahoma, COUNTY OF Oklahoma, ss.  
S. F. Blake (employee of owner) or (owner or operator) of the above-described well, being first duly sworn on oath, says: That I have knowledge of the facts, statements, and matters herein contained and the log of the above-described well as filed and that the same are true and correct. So help me God.

(Signature) S. F. Blake  
1516 Liberty Bank Building, Okla. City, Okla.  
(Address)

SUBSCRIBED AND SWORN TO before me this 29 day of August, 1957

My commission expires July 1, 1959

Carol Bradshaw  
Notary Public.

PLUGGING  
FILE SEC 5 T. 10 R. 22 W  
BOOK PAGE 39 LINE 3

RECEIVED  
STATE CORPORATION COMMISSION  
08-30-1957  
AUG 30 1957  
CONSERVATION DIVISION  
Wichita, Kansas

15-065-00991-00-00

DRILLER'S WELL LOG

Transit Corporation - Sandlin # 1 Well, SW SW NW, Sec. 5-10S-22W,  
Graham County, Kansas

Total Depth: 4140'  
Commenced: 7-30-57  
Completed: 8-14-57

Elevation 2360' KB  
Casing 8 5/8" @ 189' with  
135 Sacks Cement

Formation	Depth	
	From	To
Surface Sand and Soil	0	189
Shale and Shells	189	1485
Shale - Red Bed	1485	1625
Sand Iron	1625	1725
Shale - Red Bed	1725	1906
Anhydrite	1906	1947
Shale	1947	2140
Shale - Lime	2140	2655
Lime	2655	2745
Lime & Shale	2745	3585
Lime	3585	3661
Lime and Shale	3661	3730
Lime	3730	3884
Lime and Shale	3884	3979
Shale - Chert - Lime	3979	4020
Shale and Chert	4020	4064
Conglomerate	4064	4098
Conglomerate - Chert	4098	4140 T.D.

Formation Tops

Heebner	3596'
Toronto	3619'
Lansing	3632'
Base of Kansas City	3859'
Marmaton Chert	3944'
Conglomerate	4025'
Arbuckle	4126'
Rotary Total Depth	4140'

I hereby certify the foregoing to be a true and accurate Driller's Log of the formations encountered in the above well.

TRANSIT CORPORATION

By

*[Signature]*

Subscribed and sworn to before me this 27 day of August, 1957.

My commission expires: July 1, 1959

*[Signature]*

Notary Public

PLUGGING  
SEC 5 T 10 R 22W  
BOOK PAGE 29 LINE 3

08-30-1957