

STATE OF KANSAS  
STATE CORPORATION COMMISSION

15-065 - 00731-00-00

WELL PLUGGING RECORD

Give All Information Completely  
Make Required Affidavit  
Mail or Deliver Report to:  
Conservation Division  
State Corporation Commission  
800 Bitting Building  
Wichita, Kansas

Graham County County, Sec. 34 Twp. 10 Rge. 21 ~~SESE~~ (W)

Location as "NE/CNW/SW" or footage from lines NW NW SE

Lease Owner Herman George Kaiser

Lease Name Lewis Well No. #1

Office Address 908 Palace Bldg., Tulsa, Oklahoma

Character of Well (completed as Oil, Gas or Dry Hole) dry hole

Date well completed 5-19- 19 55

Application for plugging filed 5-19 19 55

Application for plugging approved 5-19 19 55


Plugging commenced 5-19 19 55

Plugging completed 5-19 19 55

Reason for abandonment of well or producing formation  
commercial quantities of oil not found

If a producing well is abandoned, date of last production 19

Was permission obtained from the Conservation Division or its agents before plugging was commenced? yes

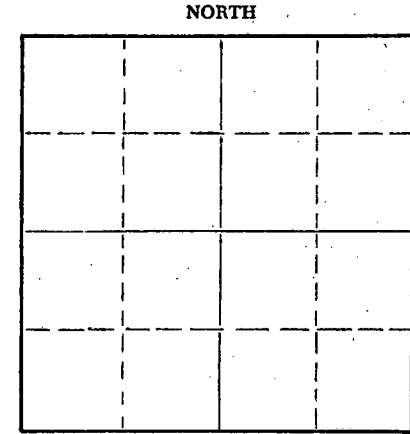

Locate well correctly on above Section Plat

Name of Conservation Agent who supervised plugging of this well Eldon Petty Box 326, Hays, Kansas

Producing formation Depth to top Bottom Total Depth of Well 3886 Feet

Show depth and thickness of all water, oil and gas formations.

OIL, GAS OR WATER RECORDS

CASING RECORD

FORMATION	CONTENT	FROM	TO	SIZE	PUT IN	PULLED OUT
				8 5/8	227	none

Describe in detail the manner in which the well was plugged, indicating where the mud fluid was placed and the method or methods used in introducing it into the hole. If cement or other plugs were used, state the character of same and depth placed, from feet to feet for each plug set.

Filled Hole with heavy mud from 3886' to 210'. Set wooden plug with 15 sacks cement. Second plug at 40' with 10 sacks cement

RECEIVED  
STATE CORPORATION COMMISSION  
MAY 24 1955  
CONSERVATION DIVISION  
Wichita, Kansas

Name of Plugging Contractor K & E DRILLING, INC.  
Address 1006 Central Bldg,

STATE OF Kansas, COUNTY OF Sedgwick, ss.  
Dale Silcott (employee or owner or operator) of the above-described well, being first duly sworn on oath, says: That I have knowledge of the facts, statements, and matters herein contained and the log of the above-described well as filed and that the same are true and correct. So help me God.

(Signature) Dale Silcott

SUBSCRIBED AND SWORN TO before me this 23rd day of May, 19 55  
My commission expires June 25, 1956  
Francis Madler Notary Public.



PLUGGING  
FILE SEC 34 T 10 R 21W  
BOOK PAGE 119 LINE 42

15-065-00731-00-00

HERMAN GEORGE KAISER  
Lewis #1

NW NW SE Sec. 34-10S-21W  
Graham County, Kansas

Comm: 5-8-55  
Comp: 5-19-55  
Total Depth: 3886'

Casing  
8 5/8" Set @ 227'

Cement  
140 sacks

<u>FORMATION</u>	<u>DEPTH</u>
Surface soil & clay	0 - 40
Shale, sand, clay	40 - 200
Blue shale	200 - 227
Shale & shells	227 - 655
Sand	1145 - 1393
Shale, shells	1393 - 1535
Red bed & shale	1535 - 1775
Shale & shells	1775 - 2170
Shale & lime	2170 - 3340
Lime	3340 - 3805
Cherty Conglomerate	3805 - 3858
Conglomerate	3858 - 3886

STATE OF KANSAS )  
                          ) SS  
SEDGWICK COUNTY )

I hereby certify that the above information is true and correct to the best of my knowledge.

  
\_\_\_\_\_

Subscribed and sworn to before me this 24th day of May, 1955

My commission expires: June 25, 1956

  
\_\_\_\_\_  
Notary Public

RECEIVED  
STATE CORPORATION  
MAY 26 1955  
05-24-1955  
CONSERVATION DIVISION  
Wichita, Kansas

PLUGGING  
FILE SEC 34-10-R-21W  
BOOK PAGE 119 LINE 42