


WELL PLUGGING RECORD

Give All Information Completely.
Make Required Affidavit
Mail or Deliver Report to:
Conservation Division
State Corporation Commission
212 No. Market
Wichita, Kansas

NORTH

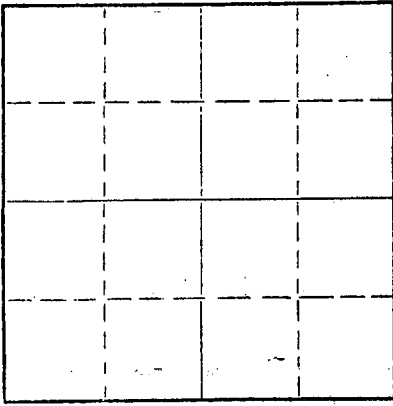

Locate well correctly on above
Section Plat

Graham County. Sec. 19 Twp. 10 Rge. 222 (E) W (W)
Location as "NE/CNW/SW" or footage from lines. SE NW NW
Lease Owner Halliburton Oil Producing Co
Lease Name Kuska Well No. 1
Office Address Cameron Building, Oklahoma City, Oklahoma
Character of Well (completed as Oil, Gas or Dry Hole) Core Hole
Date well completed 5-8-71 19__
Application for plugging filed 5-8-71 19__
Application for plugging approved 5-8-71 19__
Plugging commenced 5-8-71 19__
Plugging completed 5-8-71 19__
Reason for abandonment of well or producing formation D&A

If a producing well is abandoned, date of last production _____ 19__
Was permission obtained from the Conservation Division or its agents before plugging was commenced? yes

Name of Conservation Agent who supervised plugging of this well Mr. Nichols
Producing formation _____ Depth to top _____ Bottom _____ Total Depth of Well 1954 Feet
Show depth and thickness of all water, oil and gas formations.

OIL, GAS OR WATER RECORDS

CASING RECORD

FORMATION	CONTENT	FROM	TO	SIZE	PUT IN	PULLED OUT

Describe in detail the manner in which the well was plugged, indicating where the mud fluid was placed and the method or methods used in introducing it into the hole. If cement or other plugs were used, state the character of same and depth placed, from _____ feet to _____ feet for each plug set.

Filled hole with heavy mud, spotted 100 sacks cement from 875 to 575 through drillpipe; Spotted and circulated 100 sack cement from 275 to the surface.

RECEIVED
STATE CORPORATION COMMISSION
MAY 12 1971
CONSERVATION DIVISION
Wichita, Kansas
05-12-1971


(If additional description is necessary, use BACK of this sheet)

Name of Plugging Contractor _____
Address _____

STATE OF KANSAS COUNTY OF BARTON, ss.
L. O. Chubb (employee of owner) or (owner or operator) of the above-described well, being first duly sworn on oath, says: That I have knowledge of the facts, statements, and matters herein contained and the log of the above-described well as filed and that the same are true and correct. So help me God.

(Signature) L. O. Chubb
Box 854, Great Bend, Kansas 67530
(Address)

Subscribed and Sworn to before me this 11th day of May, 1971
Kearney M. Hague Notary Public.
My commission expires 1-74

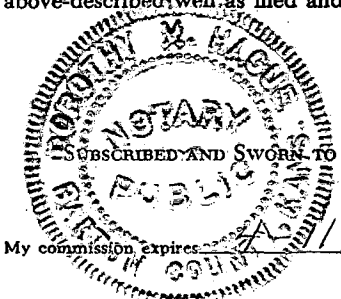

data

15-065-20442-00-00

DRILLERS WELL LOG

DATE COMMENCED 5-4-1971
DATE COMPLETED 5-8-1971

HALLIBURTON OIL PRODUCING CO
KUSKA NO. 1
SE NW NW Sec. 19-10 S- 22W
Graham county, Kansas

ELEVATION: 2354' KB

0- 80	clay
80- 250	shale
250- 320	lime
320- 580	shale
580- 860	sand
860-1200	shale & sand
1200-1400	shale
1400-1640	sand
1640-1894	shale red
1894- 1940	Anhydrite
1940-1954	Red Bed

FORMATION DATA:

Fort Hays	253'
Dakota	590'
Cedar Hills	1400'
Red Beds	1640'
Anhydrite	1894'
RTD	1954'

Cimarron Drillers, Inc

L. O. Chubb
L. O. Chubb

RECEIVED
STATE CORPORATION COMMISSION
MAY 12 1971
CONSERVATION DIVISION
Wichita, Kansas

05-12-1971