


15-065-00156-00-00

Give All Information Completely  
Make Required Affidavit  
Mail or Deliver Report to:  
Conservation Division  
State Corporation Commission  
800 Bitting Building  
Wichita, Kansas

WELL PLUGGING RECORD

NORTH

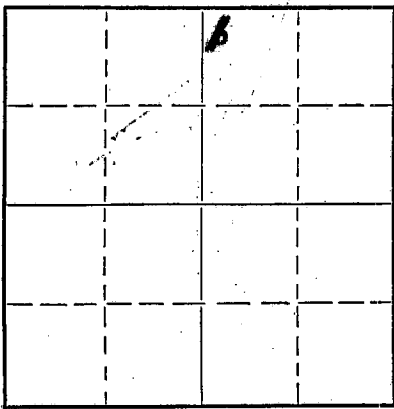

Locate well correctly on above  
Section Plat

Graham County, Sec. 23 Twp. 10S Rge. 22W  
Location as "NE/CNW $\frac{1}{4}$ /SW $\frac{1}{4}$ " or footage from lines NW $\frac{1}{4}$  NW $\frac{1}{4}$  NE $\frac{1}{4}$   
Lease Owner Kantor Oil Company, et al  
Lease Name Watkins Well No. 1  
Office Address Box 846, Tulsa, Oklahoma  
Character of Well (completed as Oil, Gas or Dry Hole) Dry Hole  
Date well completed December 19 19 50  
Application for plugging filed (Oral consent received) December 19 19 50  
Application for plugging approved December 19 19 50  
Plugging commenced December 19 19 50  
Plugging completed December 19 19 50  
Reason for abandonment of well or producing formation Dry Hole

If a producing well is abandoned, date of last production \_\_\_\_\_ 19\_\_\_\_  
Was permission obtained from the Conservation Division or its agents before plugging was commenced? Yes

Name of Conservation Agent who supervised plugging of this well Eldon Petty  
Producing formation \_\_\_\_\_ Depth to top 3903 Bottom \_\_\_\_\_ Total Depth of Well 3929 Feet  
Show depth and thickness of all water, oil and gas formations.

OIL, GAS OR WATER RECORDS

CASING RECORD

Formation	Content	From	To	Size	Put In	Pulled Out
		0	174'	8-5/8" surface casing	174'	None

Describe in detail the manner in which the well was plugged, indicating where the mud fluid was placed and the method or methods used in introducing it into the hole. If cement or other plugs were used, state the character of same and depth placed, from 45 feet to 170 feet for each plug set.

Filled hole with mud; bottom plug at 170' with 1 sack hulls & 15 sacks cement; top plug at 45' with 1/2 sack hulls and 10 sacks cement.

RECEIVED  
STATE CORPORATION COMMISSION  
DEC 22 1950  
CONSERVATION DIVISION  
Wichita, Kansas  
12-22-1950

(If additional description is necessary, use BACK of this sheet)

Correspondence regarding this well should be addressed to Kantor Oil Company

Address P. O. Box 846, Tulsa, Oklahoma

STATE OF KANSAS, COUNTY OF SEDWICK SS.  
Richard Hindery, partner of Birmingham-Bartlett Drilling Co., contractor and part-owner of the above-described well, being first duly sworn on oath, says: That I have knowledge of the facts, statements, and matters herein contained and the log of the above-described well as filed and that the same are true and correct. So help me God. BIRMINGHAM-BARTLETT DRILLING CO.  
(Signature) By Richard Hindery  
Partner  
300 Kaufman Building, Wichita 2, Kansas  
(Address)

SUBSCRIBED AND SWORN TO before me this 21st day of December, 19 50

My commission expires November 29, 1954.



PLUGGING  
FILE SEC 23 T 10 R 22  
BOOK PAGE 50 LINE 37

15-065-00156-00-00

WATKINS NO. 1 WELL

LOCATION: NW $\frac{1}{4}$  NW $\frac{1}{4}$  NE $\frac{1}{4}$  Sec. 23-108-22W SPURVED: 12-6-50

OPERATOR: Kantor Oil Company, Tulsa, Oklahoma COMPLETED: 12-19-50

CONTRACTOR: Birmingham-Bartlett Drilling Co.  
Wichita, Kansas

SURFACE CASING: Ran 6 Jts., 174.83', 8-5/8" 28#  
surface casing, cemented at 174'  
with 125 sacks cement & 1 c.c.

OIL STRING: None. D & A

LOG

(Figures indicate bottom of formation)

0 to	90	Clay and Sand
	1265	Shale and Shells
	1455	Sand
	1660	Shale and Shells
	1750	Red Bed and Shells
	1795	Anhydrite
	2200	Shale and Shells
	2810	Lime and Shale
	2880	Shale and Shells
	3435	Shale and Lime
	3570	Lime
	3720	Lime and Shale
	3800	Lime
	3830	Shale and Lime
	3855	Chert and Lime
	3903	Conglomerate
	3929	Lime
	3929	Total Depth

The undersigned, Richard Hindery, one of the partners of Birmingham-Bartlett Drilling Co., hereby certifies that the above is a true and correct log of the formations encountered in drilling the Watkins No. 1 Well, as shown on the daily drilling reports.

BIRMINGHAM-BARTLETT DRILLING CO.

By Richard Hindery  
STATE CORPORATION COMMISSION

DEC 22 1950  
CONSERVATION DIVISION  
Wichita, Kansas

12-22-1950

Subscribed and sworn to before me  
this 21st day of December, 1950.

Virvian J. Zinger  
Notary Public

My commission expires November 29, 1954.

**PLUGGING**  
FILE SEC 23 T 10 R 22  
BOOK PAGE 50 LINE 37