


STATE OF KANSAS
STATE CORPORATION COMMISSION

15-065 - 00380-00-00

WELL PLUGGING RECORD

Give All Information Completely
Make Required Affidavit
Mail or Deliver Report to:
Conservation Division
State Corporation Commission
800 Biting Building
Wichita, Kansas

NORTH

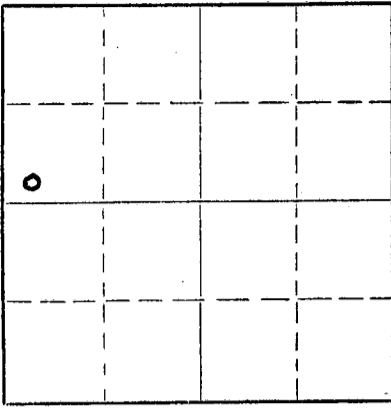

Locate well correctly on above
Section Plat

Graham County, Sec. 23 Twp. 10 Rge. (E) 22 (W)
Location as "NE/CNW/SW" or footage from lines SW/4 SW/4 NW/4
Lease Owner Sam B. Smith, Jr.
Lease Name Faulkner Well No. 1
Office Address 832 Carter, Wichita, Kansas.
Character of Well (completed as Oil, Gas or Dry Hole) Dry
Date well completed 1-7 1953
Application for plugging filed 1-7 1953
Application for plugging approved 1-7 1953
Plugging commenced 1-7 1953
Plugging completed 1-7 1953
Reason for abandonment of well or producing formation Dry

If a producing well is abandoned, date of last production None 19
Was permission obtained from the Conservation Division or its agents before plugging was commenced? Yes

Name of Conservation Agent who supervised plugging of this well Eldon Petty, Hays, Kansas
Producing formation None Depth to top Bottom Total Depth of Well 3986 Feet
Show depth and thickness of all water, oil and gas formations.

OIL, GAS OR WATER RECORDS

CASING RECORD

FORMATION	CONTENT	FROM	TO	SIZE	PUT IN	PULLED OUT
Sand and Shale	None			8 5/8"	207'	0

Describe in detail the manner in which the well was plugged, indicating where the mud fluid was placed and the method or methods used in introducing it into the hole. If cement or other plugs were used, state the character of same and depth placed, from feet to feet for each plug set.

Circulate heavy mud on bottom and half way out of hole.
Filled hole with heavy mud to 208'—Formed solid bridge to hold drill pipe &
ran 15 sacks cement through 7 joints of drill pipe—filled hole with heavy mud
to 40' and bridge hole—run 10 sacks cement filling hole to cellar floor.

RECEIVED
STATE CORPORATION COMMISSION
JAN 27 1953
01-30-1953
CONSERVATION DIVISION
Wichita, Kansas

(If additional description is necessary, use BACK of this sheet)


Name of Plugging Contractor Salina Drilling Corporation, Inc.
Address Box #566, Salina, Kansas.

STATE OF Kansas, COUNTY OF Saline, ss.
Loren W. Hallam (employee of owner) or (owner or operator) of the above-described well, being first duly sworn on oath, says: That I have knowledge of the facts, statements, and matters herein contained and the log of the above-described well as filed and that the same are true and correct. So help me God.

(Signature) Loren W. Hallam
Box 566 - Salina, Kansas (Address)

SUBSCRIBED AND SWORN TO before me this 14th day of Jan, 1953
Eldon Petty Notary Public.

My commission expires April 14, 1955
4-2675-S 2-52-20M

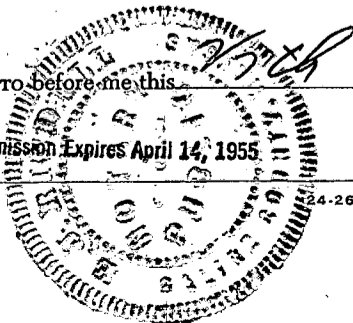

PLUGGING
FILE SEC 23 T 10 R 22
BOOK PAGE 71 LINE 41

ROTARY DRILLER'S LOG

RIG #1

Faulkner #1
 SW/4 SW/4 NW/4
 Sec. 23-10-22W
 Graham County, Kansas.

Elevation by Laughlin-Simmons
 2245' R. B.
 2242' D. F.

Casing Record
 8 5/8"-207'-135 sacks
 Cement-Circulated.

OPERATOR: SAM B. SMITH, Jr.
 832 Carter Avenue
 Wichita, 3, Kansas.

CONTRACTOR:
 Salina Drilling Corp., Inc.,
 Box #566, Salina, Kansas.

Well Commenced 12-20-52

GEOLOGIST:
 Donald H. Smith
 5206 East Central, Wichita, Kansas.

Well Completed 1-7-53

FIGURES INDICATE BOTTOM OF FORMATIONS--K.B.

Rotary Table--Base & Cellar	8	Lime & Shale	3405
Shale--Shells & Sand	207	Lime	3550
Sand--Shells & Shale	500	Lime & Shale	3603
Sand--Shale--Shells	1190	Lime	3815
Sand--Shale	1740	Shale & Lime	3875
Anhydrite	1785	Conglomerate	3895
Shale	2130	Lime	3986
Shale--Lime	3315		

FORMATIONS TOPS AS PICKED BY GEOLOGIST

Topeka	3262	Marmaton Cherty Lime	3819
Heebner	3477	Conglomerate	3870
Toronto	3500	Simpson Shale	3928
Lansing--Kansas City	3515	Arbuckle	3930
Base--Lansing	3749	R. T. D.	3986

D & A.

The above rotary driller's log is complete and correct to the best of my knowledge.

RECEIVED
 STATE CORPORATION COMMISSION

JAN 30 1953
 01-30-1953
 CONSERVATION DIVISION
 Wichita, Kansas

SALINA DRILLING CORPORATION, INC.

By Loren D. Hallam
 President.

PLUGGING
 FILE SEC 23T 10 R 22W
 BOOK PAGE 21 LINE 41