

15-065-21321-00-00

STATE OF KANSAS
STATE CORPORATION COMMISSION

WELL PLUGGING RECORD

Give All Information Completely
Make Required Affidavit
Mail or Deliver Report to
Conservation Division
State Corporation Comm.
245 North Water
Wichita, KS 67202

Graham County, Sec. 24 Twp. 10S Rge. 22W
Location as "NE/CNW $\frac{1}{4}$ SW $\frac{1}{4}$ " or footage from lines
NW NW SW


Lease Owner American Energies Corporation
Lease Name Trego Farms Well No. 1
Office Address 575 Fourth Financial Center, Wichita 67202
Character of Well (Completed as Oil, Gas or Dry Hole)
Dry Hole

Date Well completed 11/2/80 19
Application for plugging filed 11/2/80 19
Application for plugging approved 11/2/80 19
Plugging commenced 11/2/80 19
Plugging completed 11/2/80 2:45 p.m. 19
Reason for abandonment of well or producing formation

If a producing well is abandoned, date of last production 19

Was permission obtained from the Conservation Division or its agents before plugging was commenced? Yes

Name of Conservation Agent who supervised plugging of this well Gil Balthazor
Producing formation Depth to top Bottom Total Depth of Well
Show depth and thickness of all water, oil and gas formations. RTD 3907

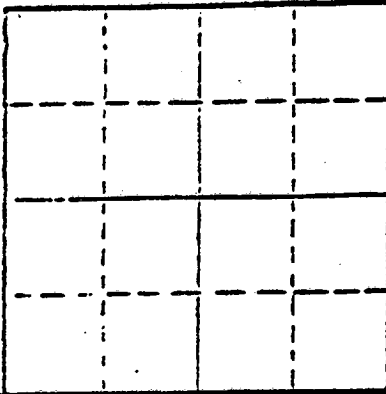

Locate well correctly on above Section Plot

OIL, GAS OR WATER RECORDS

CASING RECORD

FORMATION	CONTENT	FROM	TO	SIZE	PUT IN	PULLED OUT
	Surface	0	226	8-5/8"	yes	no

Describe in detail the manner in which the well was plugged, indicating where the mud fluid was placed and the method or methods used in introducing it into the hold. If cement or other plugs were used, state the character of same and depth placed, from feet to feet for each plug set.

1st plug @ 750' with 70 sx
2nd plug @ 220' with 20 sx
3rd plug @ 40' with 10 sx
5 sacks in rathole
Job complete @ 2:45 p.m. 11/2/80

RECEIVED
NOV 24 1980
11-24-1980

CONSERVATION DIVISION
Wichita, Kansas

(If additional description is necessary, use BACK of this sheet)

Name of Plugging Contractor Slawson Drilling Company, Inc.

STATE OF Kansas COUNTY OF Sedgwick, ss.
James C. Remsberg, Slawson Drilling Company, Inc. (employee of owner) or (owner or operator) of the above-described well, being first duly sworn on oath, says: That I have knowledge of the facts, statements, and matters herein contained and the log of the above-described well as filed and that the same are true and correct. So help me God.

(Signature) James C. Remsberg
James C. Remsberg
200-Douglas Building, Wichita, Kansas 67202
(Address)

SUBSCRIBED AND SWORN TO before me this 20 day of November, 1980



January 17, 1981

Mary Lou Taylor
Mary Lou Taylor Notary Public.

DRILLERS LOG

15-065-21321-00-00-

OPERATOR: American Energies Corporation
575 Fourth Financial Center
Wichita, Kansas 67202

WELL NAME: Trego Farms #1
NW NW SW Sec.24-10S-22W
Graham County, Kansas

CONTRACTOR: Slawson Drilling Company, Inc.
200 Douglas Building
Wichita, Kansas 67202

COMMENCED: 10/25/80

COMPLETED: 11/2/80

RTD: 3907'

SURFACE CASING: 8-5/8" set at 226' with 150 sx

0' to 229' 12 1/2" Surface Casing
229' to 537' Shale
537' to 1515' Shale & Shells
1515' to 2520' Shale
2520' to 3042' Shale & Lime
3042' to 3236' Lime & Shale
3236' to 3215' Shale & Lime
3215' to 3541' Lansing
3541' to 3600' Lime
3600' to 3700' Lime & Shale
3700' to 3907' Lime
RTD 3907'

RECEIVED
STATE GEOLOGICAL COMMISSION

NOV 24 1980
11-24-1980
CONSERVATION DIVISION
Wichita, Kansas

STATE OF KANSAS

COUNTY OF SEDGWICK

I, James C. Remsberg of the Slawson Drilling Company, Inc.
hereby state the above is an accurate copy of the Trego Farms #1 log for
American Energies Corporation.

James C. Remsberg
James C. Remsberg

Subscribed and sworn to me this
20th day of November, 1980

Mary Lou Taylor
Mary Lou Taylor, Notary

My commission expires January 17, 1981

