


WELL PLUGGING RECORD

Give All Information Completely
Make Required Affidavit
Mail or Deliver Report to:
Conservation Division
State Corporation Commission
211 No. Broadway
Wichita, Kansas

Graham County. Sec. 24 Twp. 10 Rge. 22 (E) W (W)

Location as "NE/CNWxSWx" or footage from lines SE SE SW
Lease Owner Nadel and Gussman
Lease Name H. R. Sutor Well No. 1
Office Address 1714 First National Building, Tulsa 3, Okla.
Character of Well (completed as Oil, Gas or Dry Hole) Dry
Date well completed 9-18 1956
Application for plugging filed 9-18 1956
Application for plugging approved 9-18 1956
Plugging commenced 9-18 1956
Plugging completed 9-18 1956
Reason for abandonment of well or producing formation Dry

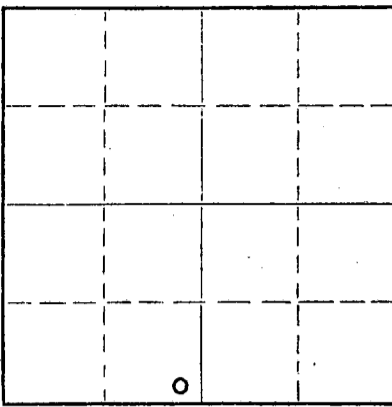

Locate well correctly on above Section Plat

If a producing well is abandoned, date of last production _____ 19____
Was permission obtained from the Conservation Division or its agents before plugging was commenced? Yes

Name of Conservation Agent who supervised plugging of this well Eldon Petty
Producing formation _____ Depth to top _____ Bottom _____ Total Depth of Well 3885 Feet
Show depth and thickness of all water, oil and gas formations.

OIL, GAS OR WATER RECORDS

CASING RECORD

FORMATION	CONTENT	FROM	TO	SIZE	PUT IN	PULLED OUT
				8-5/8"	220	0

Describe in detail the manner in which the well was plugged, indicating where the mud fluid was placed and the method or methods used in introducing it into the hole. If cement or other plugs were used, state the character of same and depth placed, from _____ feet to _____ feet for each plug set.

Filled hole from 3885 to 200' and set plug with 15 sacks cement

Set second plug at 40' with 10 sacks cement

Name of Plugging Contractor Reserve Drilling Company, Inc.
Address Wichita 2, Kansas

STATE OF KANSAS COUNTY OF SEDGWICK
L. C. Hay (employee of owner) of the above-described well, being first duly sworn on oath, says: That I have knowledge of the facts, statements, and matters herein contained and the log of the above-described well as filed and that the same are true and correct. So help me God.

(Signature) L. C. Hay

SUBSCRIBED AND SWORN TO before me this 20th day of September, 1956

My commission expires Nov. 3, 1956 _____ Notary Public.

PLUGGING
FILE SEC. 24 T. 10. R. 22W
BOOK PAGE 100 LINE 42

FILED
STATE OF KANSAS
WICHITA
SEP 20 1956

NOV 3 1956
My commission expires

NADEL AND GUSSMAN

H. R. SUTOR No. 1

SE SE SW 24-10-22W
Graham County, Kans.

Comm: 9- 8-56
Comp: 9-18-56

Casing: 8-5/8" 219' w/150 sax

Formations

Depth

Shale and shells	700
Shale, shells and sand	1400
Shale and shells	1683
Anhydrite	1735
Shale and shells	2160
Shale and lime	2405
Lime	2565
Shale and lime	3275
Lime	3885

700
1400
1683
1735
2160
2405
2565
3275
3885

Geological Tops

Heebner	3440
Toronto	3463
Lansing	3480
Base Kansas City	3715
Conglomerate	3834
Arbuckle	3871

STATE OF KANSAS)
COUNTY OF SEDGWICK) SS:

L. C. Hay, of lawful age, states that the above formations and tops are correct to his best knowledge and belief.

L. C. Hay

L. C. Hay

Subscribed and sworn to before me this 20th day of September, 1956.

Nola Babb

Nola Babb, Notary Public

My commission expires Nov. 3, 1956

PLUGGING
FILE SEC 24 T 10 R 22W
BOOK PAGE 100 LINE 42

09-22-1956