


STATE OF KANSAS
STATE CORPORATION COMMISSION

WELL PLUGGING RECORD

Give All Information Completely
Make Required Affidavit
Mail or Deliver Report to
Conservation Division
State Corporation Comm.
245 North Water
Wichita, KS 67202

Graham County. Sec. 24 Twp. 10 S Rge. 22 E/W
Location as "NE/CNW $\frac{1}{4}$ /SW $\frac{1}{4}$ " or footage from lines
NE SW SW

Lease Owner F & M Oil Co., Inc.
Lease Name Poos Well No. 1
Office Address 505 Union Center, Wichita, Ks.
Character of Well (Completed as Oil, Gas or Dry Hole)
Dry Hole

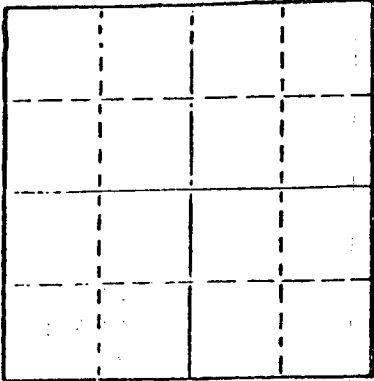

Locate well correctly on above
Section Plat

Date Well completed August 13 1977
Application for plugging filed August 13 1977
Application for plugging approved August 13 1977
Plugging commenced August 13 1977
Plugging completed August 13 1977
Reason for abandonment of well or producing formation
Dry Hole

If a producing well is abandoned, date of last production
19

Was permission obtained from the Conservation Division or
its agents before plugging was commenced? yes

Name of Conservation Agent who supervised plugging of this well Gilbert Balthazor
Producing formation Depth to top Bottom Total Depth of Well 3765
Show depth and thickness of all water, oil and gas formations.

OIL, GAS OR WATER RECORDS

CASING RECORD

FORMATION	CONTENT	FROM	TO	SIZE	PUT IN	PULLED OUT

Describe in detail the manner in which the well was plugged, indicating where the mud fluid
was placed and the method or methods used in introducing it into the hold. If cement or other
plugs were used, state the character of same and depth placed, from feet to
feet for each plug set.

Hole full of heavy mud to 900' w/70 sacks 50/50 Pozmix, 6% Gel.

Hole full of heavy mud to 200' w/20 sacks 50/50 Pozmix, 6% Gel.

Mud to 40' w/ $\frac{1}{2}$ sack hulls plug and 10 sacks cement.

RECEIVED
STATE CORPORATION COMMISSION

AUG 17 1977

08-17-1977

CONSERVATION DIVISION
Wichita, Kansas

(If additional description is necessary, use BACK of this sheet)

Name of Plugging Contractor Duke Drilling Co.

STATE OF KANSAS COUNTY OF BARTON, ss.
Larry Curtis (employee of owner) or (owner or operator)

of the above-described well, being first duly sworn on oath, says: That I have knowledge of
the facts, statements, and matters herein contained and the log of the above-described well
as filed and that the same are true and correct. So help me God.

(Signature)

Larry Curtis
Box 823, Great Bend, Kansas 67530
(Address)

SUBSCRIBED AND SWORN TO before me this 15th day of August, 1977

Deborah M. Hague
Notary Public.

My commission expires April 11, 1978



15-065-20933-00-00

DRILLERS' WELL LOG

DATE COMMENCED: August 7, 1977
DATE COMPLETED: August 13, 1977

F & M Oil Co., Inc.
POOS # 1
NE SW SW
Sec 24-T10-R22W
Graham County, Kansas

ELEVATION: 2240 K.B.

0 - 25' Clay
25 - 110' Post Rock and Shale
110 - 879' Shale
879 - 906' First Anhydrite
906 - 1420' Shale
1420 - 1731' Red Bed
1731 - 1770' Anhydrite
1770 - 3149' Shale and Lime
3149 - 3310' Lime and Shale
3310 - 3480' Lime
3480 - 3484' Shale
3484 - 3765' Lime
3765' RTD

FORMATION TOPS

Anhydrite 1731
Heebner 3480
Lansing 3511
RTD 3765

SURFACE PIPE:

Set used 8 5/8", 28# pipe
at 212' w/150 sacks Common,
2% Gel, 3% cc.

A F F I D A V I T

STATE OF KANSAS }
COUNTY OF BARTON } ss.

Larry Curtis, of lawful age, does swear and state that the facts and statements herein contained are true and correct to the best of his knowledge.

Larry Curtis

Subscribed and sworn to before me this 16th day of August, 1977.

Alcester M. Haque
Notary Public



My Commission Expires: April 11, 1978

RECEIVED
STATE CORPORATION COMMISSION
AUG 17 1977
08-17-1977
CONSERVATION DIVISION
Wichita, Kansas