

KANSAS CORPORATION COMMISSION
OIL & GAS CONSERVATION DIVISION

Form CP-1
September 2003
Form must be Typed
Form must be Signed
All blanks must be Filled

WELL PLUGGING APPLICATION

Please TYPE Form and File ONE Copy

API # 15- 187-20840-0000 (Identifier Number of this well). This must be listed for wells drilled since 1967; if no API # was issued.

Indicate original spud or completion date 6/16/1996 Spud

Well Operator: Presco Western, LLC KCC License #: 32309
(Owner/Company Name) (Operator's)

Address: 5665 Flatiron Parkway City: Boulder

State: CO Zip Code: 80301 Contact Phone: 303 305-1163

Lease: Dwight LeRoy Well #: 1-35 Sec. 35 Twp. 29 R. 40 East West

C - NW - SW - Spot Location/QQQQ County Stanton

1,980 Feet from (in exact footage) North / South (from nearest outside section corner) Line of Section (not Lease Line)

660 Feet from (in exact footage) East / West (from nearest outside section corner) Line of Section (not Lease Line)

Check One: Oil Well Gas Well D&A Cathodic Water Supply Well
 SWD Docket # _____ ENHR Docket # _____ Other _____

Conductor Casing Size: N/A Set at: N/A Cemented with: N/A Sacks

Surface Casing Size: 8-5/8" Set at: 1,706' Cemented with: 650 Sacks

Production Casing Size: 4-1/2" Set at: 5,750' Cemented with: 850 Sacks

List (ALL) Perforations and Bridgeplug Sets: Perforated @ 5,612-5,620'

Elevation: 3,255' (G.L. K.B.) T.D. 5,750' PBDT 5,718' Anhydrite Depth _____
(Stone Corral Formation)

Condition of Well: Good Poor Casing Leak Junk in Hole

Proposed Method of Plugging (attach a separate page if additional space is needed): CIBP @ 5,550' w/ 2 SKS cement. Plug at
1,743' w/ 50 SKS cement. Plug at 690' to surface w/ 50 SKS cement.

RECEIVED
KANSAS CORPORATION COMMISSION

Is Well Log attached to this application as required? Yes No Is ACO-1 filed? Yes No

OCT 09 2008

If not explain why? _____
CONSERVATION DIVISION
WICHITA, KS

Plugging of this Well will be done in accordance with K.S.A. 55-101 et. seq. and the Rules and Regulations of the State Corporation Commission

List Name of Company Representative authorized to be in charge of plugging operations:

Kevin Newman 620-309-8413 Tony Aton 620-356-5401 Phone: 620 655-1958

Address: 303 S. Stubbs Rd. City/State Ulysses, KS

Plugging Contractor Presco Western, LLC (Basic Energy) KCC License # 32309
(Company Name) (Contractor's)

Address 5665 Flatiron Parkway, Boulder, CO 80301 Phone: 303 305-1163

Proposed Date and Hour of Plugging (If known?): _____

Payment of the Plugging Fee (K.A.R. 82-3-118) will be guaranteed by Operator or Agent

Date: 10/8/08 Authorized Operator / Agent: Keli Kowalski
(Signature)

Keli Kowalski

Dust
PK



Daily Completion and Workover


OCT 09 2008

Well Name: Dwight Leroy 1-35

CONSERVATION DIVISION
WICHITA, KS

API/UWI 15-187-20840-0000	Surface Legal Location Sec 35 T29S R40W c nw sw	Field Name KB-Ground Distance (ft) 13.00	License No. 32309	State/Province Kansas	Well Configuration Type
Ground Elevation (ft) 3,255.00	Casing Flange Elevation (ft)	KB-Casing Flange Distance (ft)	Spud Date 6/13/1996	Rig Release Date 7/10/1996	

Well Config: - Original Hole, 10/2/2008 10:07:56 AM

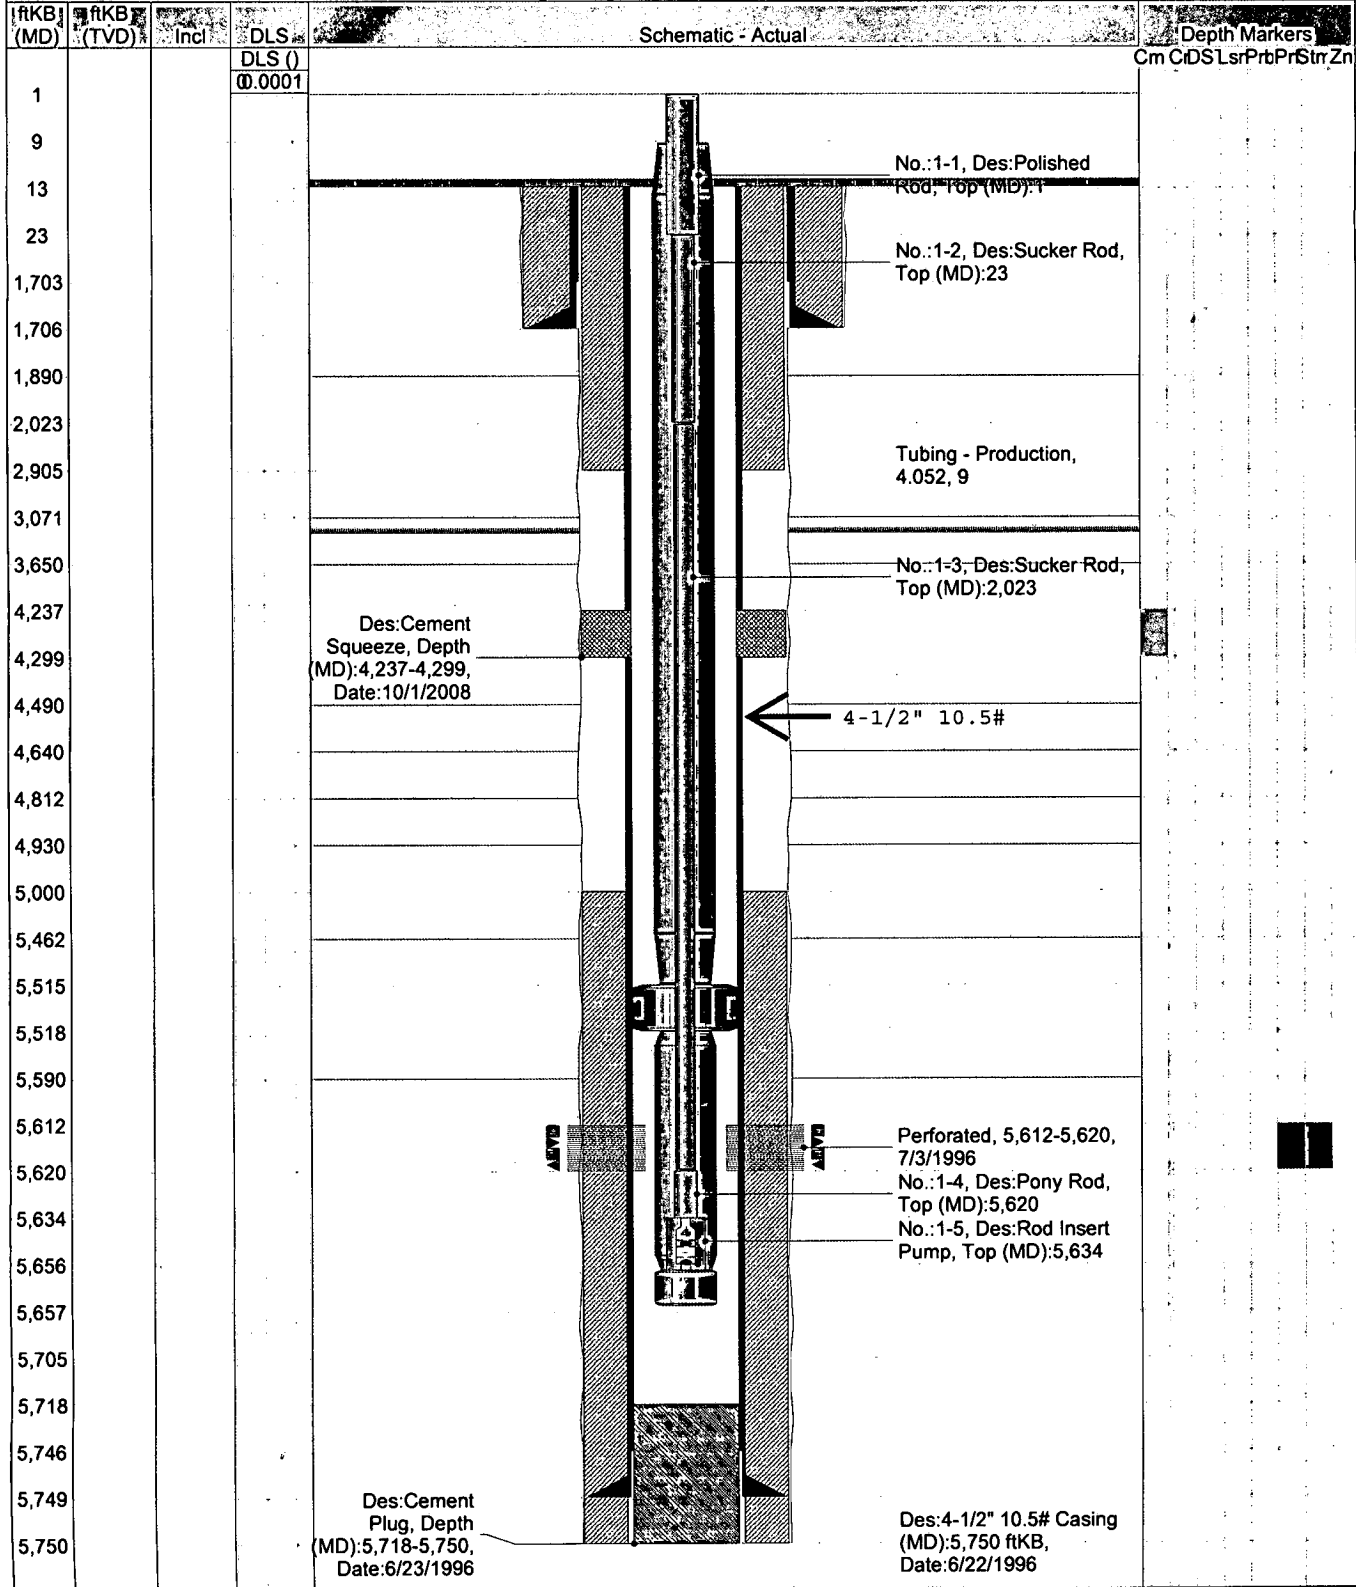



CORPORATION COMMISSION

Kathleen Sebelius, Governor Thomas E. Wright, Chairman Michael C. Moffet, Commissioner Joseph F. Harkins, Commissioner

NOTICE OF RECEIPT OF WELL PLUGGING APPLICATION (CP-1)

PRESCO WESTERN LLC
5665 FLATIRON PKWY
BOULDER, CO 80301

October 15, 2008

Re: DWIGHT LEROY #1-35
API 15-187-20840-00-00
35-29S-40W, 1980 FSL 660 FWL
STANTON COUNTY, KANSAS

Dear Operator:

This letter is to notify you that the Conservation Division has received your plugging proposal, form CP-1, for the above well and has reviewed the proposal for completeness. The central office will now forward your CP-1 to the district office listed below for review of the proposed plugging method. **Please contact the district office for approval of your proposed plugging method at least five (5) days before plugging the well, pursuant to K.A.R. 82-3-113(b). If a workover pit will be used during the plugging of the well it must be permitted. A CDP-1 form must be filed and approved prior to the use of the pit in accordance with K.A.R. 82-3-600.**

The Conservation Division's review of form CP-1, either in the central or district office, does not include an inquiry into well ownership or the filing operator's legal right to plug the well. This notice in no way constitutes authorization to plug the above well by persons not having legal rights of ownership or interest in the well.

This notice is void after April 13, 2009. The CP-1 filing does not bring the above well into compliance with K.A.R. 82-3-111 with regard to the Commission's temporary abandonment requirements.

Sincerely,

Steve Bond
Production Department Supervisor

District: #1
210 E Frontview, Suite A
Dodge City, KS 67801
(620) 225-8888