

STATE CORPORATION COMMISSION OF KANSAS
OIL & GAS CONSERVATION DIVISION

WELL COMPLETION OR RECOMPLETION FORM
ACO-1 WELL HISTORY

DESCRIPTION OF WELL AND LEASE

Operator: license # 9008
name Sun Belt Petroleum
address 7346 N. 51st Ave.
City/State/Zip Glendale, AZ 85301

Operator Contact Person Al Gross
Phone 602-931-6015 or 938-8818

Contractor: license # 6324
name Ranger Drilling
Hays, KS 67601

Wellsite Geologist John Paluga
Phone 303-697-1142

Designate Type of Completion
 New Well Re-Entry Workover

Oil SWD Temp Abd
 Gas Inj Delayed Comp.
 Dry Other (Core, Water Supply etc.)

If OWWO: old well info as follows:
Operator
Well Name
Comp. Date Old Total Depth

WELL HISTORY

Drilling Method: Mud Rotary Air Rotary Cable

Spud Date Date Reached TD Completion Date
6-29-84 7-6-84 7-6-84

Total Depth PBDT
4125 4125
Amount of Surface Pipe Set and Cemented at 248 feet

Multiple Stage Cementing Collar Used? Yes No
If Yes, Show Depth Set feet

If alternate 2 completion, cement circulated from feet depth to w/ SX cmt

API NO. 15-065-22,014-00-00
County Graham County
NE 29 10 25W East West

4950 Ft North from Southeast Corner of Section
990 Ft West from Southeast Corner of Section
(Note: locate well in section plat below)


Lease Name Bellerieve Well# 1

Field Name N/A

Producing Formation N/A

Elevation: Ground 2533 KB 2538

Section Plat

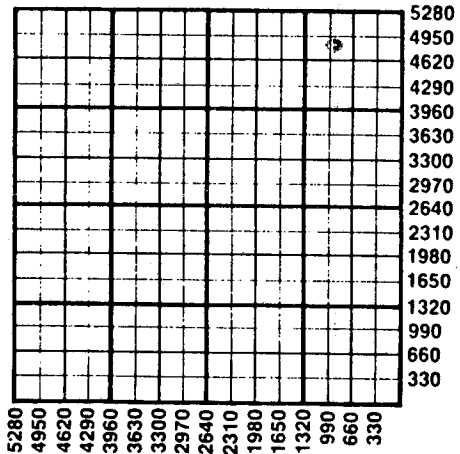

WATER SUPPLY INFORMATION

Source of Water:
Division of Water Resources Permit #
 Groundwater Ft North From Southeast Corner and Ft West From Southeast Corner of (Well) Sec Twp Rge East West
 Surface Water Ft North From Southeast Corner and Ft West From Southeast Corner (Stream, Pond etc.) Sec Twp Rge East West
 Other (explain) purchased from Tank Sers (purchased from city, R.W.D.#)

Disposition of Produced Water: Disposal Repressuring
Docket #

INSTRUCTIONS: This form shall be completed in duplicate and filed with the Kansas Corporation Commission, 200 Colorado Derby Building, Wichita, Kansas 67202, within 90 days after completion or recompletion of any well. Rules 82-3-130 and 82-3-107 apply.
Information on side two of this form will be held confidential for a period of 12 months if requested in writing and submitted with the form. See rule 82-3-107 for confidentiality in excess of 12 months.
One copy of all wireline logs and drillers time log shall be attached with this form. Submit CP-4 form with all plugged wells. Submit CP-111 form with all temporarily abandoned wells.

RECEIVED
STATE CORPORATION COMMISSION
08-10-1984
AUG 10 1984

All requirements of the statutes, rules, and regulations promulgated to regulate the oil and gas industry have been fully complied with and the statements herein are complete and correct to the best of my knowledge.

CONSERVATION DIVISION
Wichita, Kansas

Signature Allen Gross
Title Pres
Date 8-3-84

Subscribed and sworn to before me this 3 day of August 1984
Notary Public Kathleen A. Mitwall
Date Commission Expires My Commission Expires Sept. 12, 1987

K.C.C. OFFICE USE ONLY
F Letter of Confidentiality Attached
C Wireline Log Received
C Drillers Timelog Received
Distribution
 SWD/Rep NGPA
 Plug Other (Specify)

Form ACO-1
(This form supercedes previous forms ACO-1 & C-10)

Sec 29 Twp 10 Rge 25W

