

15-065-01083-00-00




STATE OF KANSAS
STATE CORPORATION COMMISSION

WELL PLUGGING RECORD

Give All Information Completely
Make Required Affidavit
Mail or Deliver Report to:
Conservation Division
State Corporation Commission
211 No. Broadway
Wichita, Kansas

Graham County. Sec. 1 Twp. 10S Rge. (E) 25 (W)
Location as "NE/CNW/SW" or footage from lines NW SE
Lease Owner Kimbark Exploration Company
Lease Name ANTON Well No. 1
Office Address 201 University Blvd. - Denver, Colorado
Character of Well (completed as Oil, Gas or Dry Hole) Dry hole
Date well completed 9/17 1963
Application for plugging filed 9/17 1963
Application for plugging approved 9/20 1963
Plugging commenced 9/17 1963
Plugging completed 9/17 1963
Reason for abandonment of well or producing formation _____

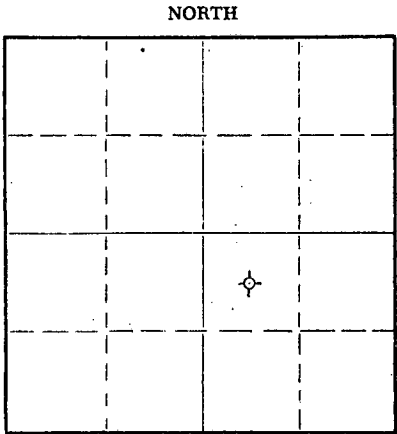

Locate well correctly on above
Section Plat

If a producing well is abandoned, date of last production _____ 19____
Was permission obtained from the Conservation Division or its agents before plugging was commenced? yes

Name of Conservation Agent who supervised plugging of this well _____
Producing formation _____ Depth to top _____ Bottom _____ Total Depth of Well _____ Feet
Show depth and thickness of all water, oil and gas formations.

OIL, GAS OR WATER RECORDS

CASING RECORD

FORMATION	CONTENT	FROM	TO	SIZE	PUT IN	PULLED OUT
		Surface	196'	8 5/8"	196'	

Describe in detail the manner in which the well was plugged, indicating where the mud fluid was placed and the method or methods used in introducing it into the hole. If cement or other plugs were used, state the character of same and depth placed, from _____ feet to _____ feet for each plug set.

540' - 20 sacks cement
175' - 20 sacks cement
top - 10 sacks cement

RECEIVED
STATE CORPORATION COMMISSION

OCT 1 1963
10-01-63

CONSERVATION DIVISION
Wichita, Kansas

Name of Plugging Contractor Same (If additional description is necessary, use BACK of this sheet)
Address _____


STATE OF COLORADO, COUNTY OF DENVER Adams, ss.
W. K. Arbuckle (employee of owner) or (owner or operator) of the above-described well, being first duly sworn on oath, says: That I have knowledge of the facts, statements, and matters herein contained and the log of the above-described well as filed and that the same are true and correct. So help me God.

(Signature) W. K. Arbuckle
W. K. Arbuckle, President
201 University Blvd., Denver, Colorado
(Address)

SUBSCRIBED AND SWORN TO before me this 27th day of September

My commission expires August 20, 1964

Audrey Davis
Audrey Davis
Notary Public

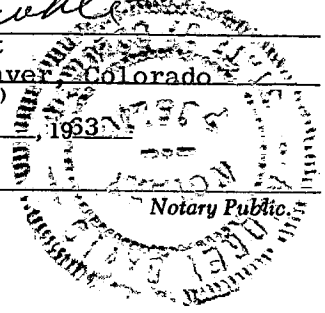

9

ANTON #1 Well

Location: C NW SE Section 1
T-10S, R-25W
Graham, Kansas

Spudded: 9/6/63
Completed: 9/17/63

Owner: Kimbark Exploration Company
201 University Blvd.
Denver 6, Colorado

Contractor: Kimbark Exploration Company
201 University Blvd.
Denver 6, Colorado

Surface Casing: 8 5/8" ss casing cemented at 196' with 150 sacks quick set.

Oil String: None

LOG

Figures indicate bottom of formation.

RECEIVED
STATE CORPORATION COMMISSION

OCT 1 1963

CONSERVATION DIVISION
Wichita, Kansas

200	Shale
1,200	Shale - Sand
2,200	Andhydrite
2,775	Shale - Lime
3,075	Lime - Shale
3,350	Lime
3,645	Lime
3,814	Lime & Shale
3,905	Lime
3,973	Lime
4,019	Lime & Shale
4,060	Rotary Total Depth

The undersigned, W. K. Arbuckle, President of Kimbark Exploration Company, hereby certifies that the above is a true and correct log of the formations encountered in drilling the Anton #1 as shown in the daily drilling reports.

KIMBARK EXPLORATION COMPANY

W. K. Arbuckle

W. K. Arbuckle, President

STATE OF COLORADO)
~~CITY & COUNTY OF DENVER~~) ss:
Adams

Be it remembered that on this 27th day of September A.D. 1963, before me, Audrey Davis, a Notary Public, personally appeared W. K. Arbuckle, President of Kimbark Exploration Company, a Colorado Corporation, who is personally known to me and known to me to be the President of said Corporation, and the same person who executed the foregoing instrument, and he duly acknowledged the execution of the same for and on behalf of and as the act and deed of said Corporation.

WITNESS my hand and official seal:
My Commission Expires August 20, 1964

Audrey Davis
Notary Public

