


WELL PLUGGING RECORD

Give All Information Completely
Make Required Affidavit
Mail or Deliver Report to:
Conservation Division
State Corporation Commission
212 North Market, Insurance Bldg.
Wichita, Kansas

Graham County, Sec. 3 Twp. 10S Rge. 25W (E) (W)

Location as "NE/CNW%SW%" or footage from lines NE NE SE
Lease Owner Alva Oil Corp. & Leben Drilling, Inc.
Lease Name Fox Well No. 1
Office Address 905 Central Bldg., Wichita, Kansas
Character of Well (completed as Oil, Gas or Dry Hole) Dry Hole
Date well completed 4-22-60 19
Application for plugging filed 4-22-60 19
Application for plugging approved 4-22-60 19
Plugging commenced 4-22-60 19
Plugging completed 4-22-60 19
Reason for abandonment of well or producing formation Dry Hole

NORTH

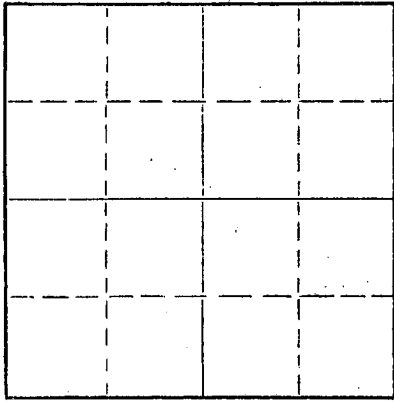

Locate well correctly on above
Section Plat

If a producing well is abandoned, date of last production _____ 19____
Was permission obtained from the Conservation Division or its agents before plugging was commenced? Yes

Name of Conservation Agent who supervised plugging of this well A. D. Fabricius
Producing formation _____ Depth to top _____ Bottom _____ Total Depth of Well 4075 Feet
Show depth and thickness of all water, oil and gas formations.

OIL, GAS OR WATER RECORDS

CASING RECORD

FORMATION	CONTENT	FROM	TO	SIZE	PUT IN	PULLED OUT
				8 5/8	210	

Describe in detail the manner in which the well was plugged, indicating where the mud fluid was placed and the method or methods used in introducing it into the hole. If cement or other plugs were used, state the character of same and depth placed, from _____ feet to _____ feet for each plug set.

1st plug set @ 400' w/ 20 sacks cement.
2nd plug set @ 205' w/ 20 sacks cement.
Top plug set @ 40' w/ 10 sacks cement.

RECEIVED
STATE CORPORATION COMMISSION
MAY 4 1960
05-04-60
CONSERVATION DIVISION
Wichita, Kansas

(If additional description is necessary, use BACK of this sheet)
Name of Plugging Contractor Leben Drilling, Inc.
Address 905 Central Bldg., Wichita, Kansas

STATE OF KANSAS, COUNTY OF SEDGWICK, ss.
Frank Hamlin (employee of owner) or (owner or operator) of the above-described well, being first duly sworn on oath, says: That I have knowledge of the facts, statements, and matters herein contained and the log of the above-described well as filed and that the same are true and correct. So help me God.

(Signature) Frank Hamlin
905 Central Bldg., Wichita, Kans. (Address)

SUBSCRIBED AND SWORN TO before me this 28th day of April, 19 60
Juanita M. Green
My commission expires April 23, 1963 Juanita M. Green Notary Public.



DRILLER'S LOG

COMPANY: ALVA OIL CORPORATION & LEBEN DRILLING, INC.
 CONTRACTOR: LEBEN DRILLING, INC.
 FARM: FOX #1
 LOCATION: NE NE SE SEC. 3-10S-25W
 GRAHAM COUNTY, KANSAS
 COMMENCED: 4-14-60
 COMPLETED: 4-22-60
 2531 KB

0	80	Surface Soil & Sand
80	210	Shale, Shells & Blue Shale
210	1030	Blue Shale
1030	1300	Shale
1300	1725	Sand & Shale
1725	2180	Shale, Sand & Red Bed
2180	2190	Anhydrite
2190	2220	Anhydrite
2220	2460	Red Bed & Shells
2460	2625	Shale & Shells
2625	2840	Shale & Shells
2840	2995	Lime & Shale
2995	3450	Lime & Shale
3450	3695	Lime & Shale
3695	3755	Lime
3755	3851	Lime
3851	3930	Lime
3930	4040	Lime
4040	4075	Lime
	<u>4075</u>	<u>Rotary Total Depth - D & A</u>

Set 8 5/8" surface casing @ 210' with 175 sacks cement with HA5.

I, Frank Hamlin, do hereby certify that the above and foregoing is a true and correct copy of the log of the Fox #1, located NE NE SE of Section 3, Township 10 South, Range 25 West, Graham County, Kansas, as reflected by the files of Leben Drilling, Inc.

Frank Hamlin
Frank Hamlin

STATE OF KANSAS)
COUNTY OF SEDGWICK)

Subscribed and sworn to before me, a Notary Public, in and for Sedgwick County, Kansas, this 28th day of April, 1960.

Juanita M. Green
Juanita M. Green, Notary Public

