

STATE OF KANSAS
STATE CORPORATION COMMISSION


WELL PLUGGING RECORD

Give All Information Completely
Make Required Affidavit
Mail or Deliver Report to:
Conservation Division
State Corporation Commission
211 No. Broadway
Wichita, Kansas

Graham County. Sec. 7 Twp. 10 S Rge. (E) 25 (W)

Location as "NE/CNW/SW" or footage from lines. NE NE SW
Lease Owner Kimbark Exploration Company
Lease Name Kuhn Well No. 1
Office Address 201 University Blvd. - Denver 6, Colo.
Character of Well (completed as Oil, Gas or Dry Hole) Dry Hole
Date well completed 6/6 19 62
Application for plugging filed 6/6 19 62
Application for plugging approved 6/6 19 62
Plugging commenced 6/6 19 62
Plugging completed 6/11 19 62
Reason for abandonment of well or producing formation _____

NORTH

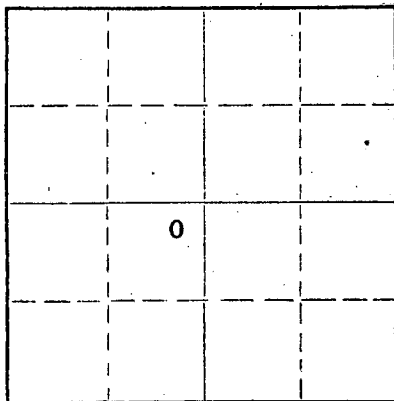

Locate well correctly on above
Section Plat

If a producing well is abandoned, date of last production _____ 19____
Was permission obtained from the Conservation Division or its agents before plugging was commenced? Yes

Name of Conservation Agent who supervised plugging of this well Eldon Pettey
Producing formation _____ Depth to top _____ Bottom _____ Total Depth of Well 4030 Feet
Show depth and thickness of all water, oil and gas formations.

OIL, GAS OR WATER RECORDS

CASING RECORD

FORMATION	CONTENT	FROM	TO	SIZE	PUT IN	PULLED OUT
				8 5/8"	204	0
				4 1/2	4027	3372

Describe in detail the manner in which the well was plugged, indicating where the mud fluid was placed and the method or methods used in introducing it into the hole. If cement or other plugs were used, state the character of same and depth placed, from _____ feet to _____ feet for each plug set.

Set rubber plug and 3 sacks cement at 3900'.
Filled hole with mud. Shot pipe at 3372'. Pulled pipe.
Set 20 sacks cement plug at 2260'. Filled hole with mud.
Set 20 sacks cement at 204'. Set 10 sacks cement in top of surface pipe.

RECEIVED
STATE CORPORATION COMMISSION

JUN 21 1962

CONSERVATION DIVISION
Wichita, Kansas


(If additional description is necessary, use BACK of this sheet)

Name of Plugging Contractor Rocket Oil Well Service Company
Address Box 4748, Denver, Colo.

STATE OF Colorado, COUNTY OF Denver, ss.
W. K. Arbuckle (employee of owner) or (owner or operator) of the above-described well, being first duly sworn on oath, says: That I have knowledge of the facts, statements, and matters herein contained and the log of the above-described well as filed and that the same are true and correct. So help me God.

(Signature) W. K. Arbuckle
201 Univ. Blvd. - Denver, Colo.
(Address)

SUBSCRIBED AND SWORN to before me this 19th day of June, 19 62
November 15, 1964
My commission expires _____
Notary Public.

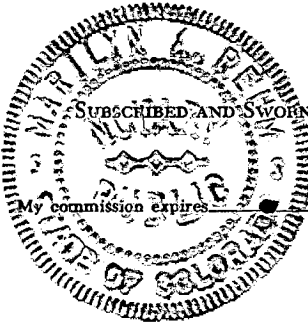

KUHN #1 WELL

Location: NE NE SW Section 7
T-10-S, R-25-W
Graham County, Kansas

Spudded: 3/14/62
Completed: 4/9/62
KB: 2527

Owner: Kimbark Exploration Company
201 University Blvd.
Denver 6, Colorado

Contractor: Kimbark Exploration Co.
201 University Blvd.
Denver 6, Colorado

Surface Casing: 8 5/8" ss casing cemented at 204' K.B. with 165 sxs quick set.

Oil String: 4 1/2", J-55 casing set at 4028'.

LOG

Figures indicate bottom of formation

212	Clay-Sand-Shale
1,100	Shale
1,610	Shale-Sand
2,430	Shale
2,635	Shale-Shell
2,755	Lime-Shale
2,950	Lime
3,235	Lime
3,510	Lime
3,735	Lime
3,877	Lime
4,000	Lime
4,030	Lime
4,030	Rotary Total Depth

RECEIVED
STATE CORPORATION COMMISSION

JUN 9 1 1962

CONSERVATION DIVISION
Wichita, Kansas


The undersigned, W. K. Arbuckle, President of Kimbark Exploration, hereby certifies that the above is a true and correct log of the formations encountered in drilling the Kuhn #1 as shown in the daily drilling reports.

KIMBARK EXPLORATION COMPANY




W. K. Arbuckle, President

STATE OF COLORADO) ss
CITY & COUNTY OF DENVER)

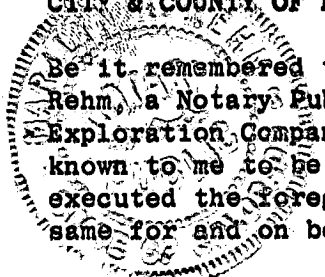

Be it remembered that on this 19th day of June A.D. 1962, before me, Marilyn A. Rehm, a Notary Public, personally appeared W. K. Arbuckle, President of Kimbark Exploration Company a Colorado Corporation, who is personally known to me and known to me to be the President of said Corporation, and the same person who executed the foregoing instrument, and he duly acknowledged the execution of the same for and on behalf of and as the act and deed of said Corporation.

WITNESS my hand and official seal:
My Commission Expires November 15, 1964


Notary Public