

Give All Information Completely  
Make Required Affidavit  
Mail or Deliver Report to:  
Conservation Division  
State Corporation Commission  
211 No. Broadway  
Wichita, Kansas

WELL PLUGGING RECORD

Graham County. Sec. 7 Twp. 10S Rge. (E) 25 (W)

Location as "NE/CNW/SW" or footage from lines NE SE NW

Lease Owner ~~KIMEX~~ Kimbark Exploration Co (AUBK)

Lease Name Martin Well No. 1

Office Address 201 University Blvd. Denver 6, Colorado

Character of Well (completed as Oil, Gas or Dry Hole) Dry hole

Date well completed 10/8 1963

Application for plugging filed 10/8 1963

Application for plugging approved 10/8 1963


Plugging commenced 10/8 1963

Plugging completed 10/8 m 1963

Reason for abandonment of well or producing formation dry

If a producing well is abandoned, date of last production 19

Was permission obtained from the Conservation Division or its agents before plugging was commenced?

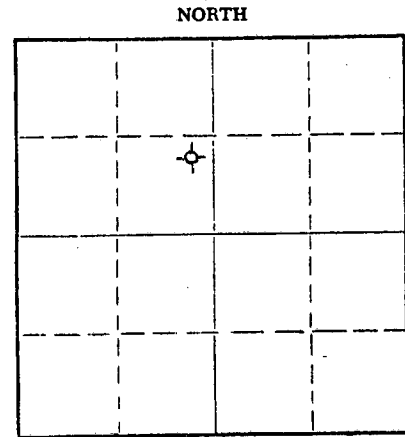

Locate well correctly on above Section Plat

Name of Conservation Agent who supervised plugging of this well W. L. Nichols  
Producing formation 0 Depth to top  Bottom  Total Depth of Well 4022 Feet

Show depth and thickness of all water, oil and gas formations.

OIL, GAS OR WATER RECORDS

CASING RECORD

FORMATION	CONTENT	FROM	TO	SIZE	PUT IN	PULLED OUT
		0	197	8 5/8	197	0

Describe in detail the manner in which the well was plugged, indicating where the mud fluid was placed and the method or methods used in introducing it into the hole. If cement or other plugs were used, state the character of same and depth placed, from 0 feet to 600-550 feet for each plug set.  
20 sacks cement  
180-150 20 sacks cement  
40-0 10 sacks cement

RECEIVED  
STATE CORPORATION COMMISSION  
12-9-63  
DEC 9 1963  
CONSERVATION DIVISION  
Wichita, Kansas


Name of Plugging Contractor Kimbark Exploration (If additional description is necessary, use BACK of this sheet)  
Address 201 University Blvd. Denver 6, Colorado

STATE OF Colorado, COUNTY OF Denver, ss.  
W. K. Arhuckle (employee of owner) or (owner or operator) of the above-described well, being first duly sworn on oath, says: That I have knowledge of the facts, statements, and matters herein contained and the log of the above-described well as filed and that the same are true and correct. So help me God.

(Signature) W. K. Arhuckle  
201 University Blvd. Denver 6, Colorado  
(Address)

SUBSCRIBED AND SWORN TO before me this 5 day of December, 1963

My commission expires My Commission expires August 20, 1964

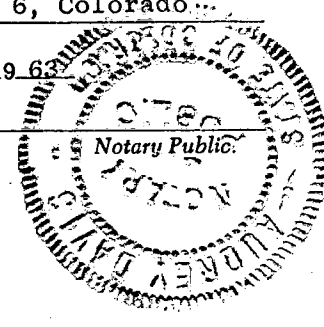

MARTIN #1 WELL

NE SE NW Section 7  
T-10-S, R-25-W

Spudded: 9/26/63  
Completed: 10/8/63

Owner: Kimbark Exploratin Company.  
201 University Blvd.  
Denver6, Colorado

Contractor: KB:2550  
Kimbark Exploration Co.  
201 University Blvd.  
Denver 6, Colorado

Surface Casing: 8 5/8" new. screw. pipe set at 197' with 160 sacks cement.

LOG

Figures indicate bottom of formation

200	Clay & Shale
1,610	Shale
2,318	Shale
2,805	Shale
3,115	Lime & Shale
3,267	Lime
3,485	Lime
3,721	Lime
3,828	Lime
3,891	Lime
3,945	Lime
3,997	Lime
4,020	Lime
4,020	Rotary Total Depth

**RECEIVED**  
STATE CORPORATION COMMISSION

DEC 9 1963

CONSERVATION DIVISION  
Wichita, Kansas

The undersigned, W. K. Arbuckle, President of Kimbark Exploration, hereby certifies that the above is a true and correct log of the formations encountered in drilling the Martin #1 as shown in the daily drilling reports.

KIMBARK EXPLORATION COMPANY

*W. K. Arbuckle*  
W. K. Arbuckle, President

STATE OF COLORADO ) ss  
CITY & COUNTY OF DENVER)

Be it remembered that on this 5th day of December A.D. 1963, before me, Audrey Davis a Notary Public, personally appeared W. K. Arbuckle, President of Kimbark Exploration Company a Colorado Corporation, who is personally known to me and known to me to be the President of said Corporation, and the same person who executed the foregoing instrument, and he duly acknowledged the execution of the same for and on behalf of and as the act and deed of said Corporation.

WITNESS my hand and official seal:  
My Commission Expires August 20, 1964

*Audrey Davis*  
Notary Public  
