

Notice: Fill out COMPLETELY and return to Conservation Division at the address below within 60 days from plugging date.

KANSAS CORPORATION COMMISSION
OIL & GAS CONSERVATION DIVISION
WELL PLUGGING RECORD
K.A.R. 82-3-117

Form CP-4
December 2003
Type or Print on this Form
Form must be Signed
All blanks must be Filled

Lease Operator: Calvin Noah
Address: 329 N. Birch Valley Center, Kansas 67147
Phone: (316) 755-1032 Operator License #: 5616
Type of Well: D&A Docket #: _____
(Oil, Gas D&A, SWD, ENHR, Water Supply Well, Cathodic, Other) (If SWD or ENHR)
The plugging proposal was approved on: 7-02-08 (Date)
by: KCC - Hays Office - per state regulations (KCC District Agent's Name)
Is ACO-1 filed? Yes No If not, is well log attached? Yes No
Producing Formation(s): List All (If needed attach another sheet)

Depth to Top: _____ Bottom: _____ T.D. _____

Depth to Top: _____ Bottom: _____ T.D. _____

Depth to Top: _____ Bottom: _____ T.D. _____

API Number: 15 - 163-23,739-00-00
Lease Name: Alphin Family
Well Number: #1
Spot Location (QQQQ): NW - SW - NE -
1650 Feet from North / South Section Line
2310 Feet from East / West Section Line
Sec. 30 Twp. 10 S. R. 20 East West
County: Rooks
Date Well Completed: 7-03-08
Plugging Commenced: 7-03-08
Plugging Completed: 7-03-08

Show depth and thickness of all water, oil and gas formations.

Oil, Gas or Water Records		Casing Record (Surface Conductor & Production)				
Formation	Content	From	To	Size	Put In	Pulled Out
				8 5/8"	255	0

Describe in detail the manner in which the well is plugged, indicating where the mud fluid was placed and the method or methods used in introducing it into the hole. If cement or other plugs were used, state the character of same depth placed from (bottom), to (top) for each plug set.

25 sacks @ 1600'; 100 sacks @ 850'; 40 sacks @ 300'; 10 sacks @ 40'; 15 sacks rathole

Name of Plugging Contractor: Anderson Drilling License #: 33237
Address: P.O. Box 100 Hill City, Kansas 67642

RECEIVED
KANSAS CORPORATION COMMISSION
OCT 02 2008

Name of Party Responsible for Plugging Fees: Calvin Noah
State of Kansas County, Sedgwick, ss.
Joan Noah (Employee of Operator) or (Operator) on above-described well, being first duty


CONSERVATION DIVISION
WICHITA, KS

sworn on oath, says: That I have knowledge of the facts statements, and matters herein contained, and the log of the above-described well is as filed, and the same are true and correct, so help me God.

(Signature) Joan Noah
(Address) 329 N. Birch Valley Center, Kansas 67147

state of Kansas)
County of Sedgwick)

SUBSCRIBED and SWORN TO before me this 30th day of September, 2008
[Signature] My Commission Expires: 7/31/2012
Notary Public

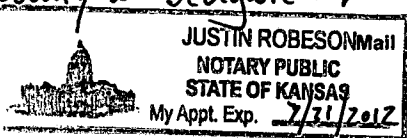

Mail to: KCC - Conservation Division, 130 S. Market - Room 2078, Wichita, Kansas 67202

[Signature]

ANDERSON DRILLING
PO BOX 100
HILL CITY KS 67642
785-421-6266
FAX 785-421-2483

RIG NUMBER 785-421-8070

CALVIN NOAH
329 N BIRCH
VALLEY CENTER, KS 67147
785-743-2505

CONTRACTOR: ANDERSON DRILLING
GEOLOGIST: KITT NOAH cell 316-841-9510
LEASE: ALLPHIN FAMILY
WELL: # 1

DAILY DRILLING REPORT

06-25 7:00 AM Move rig on location; Spud Well. Drilling surface pipe; Set 255' of
8 5/8" of surface pipe at 260' with 175 sacks of COM; 3% CC; 2% Gel;
Plug down at 2:30 AM
06-26 7:00 AM Wait on cement
06-27 7:00 AM 1575' Drilling ahead Anhydrite Top 1573'
06-28 7:00 AM 2211' Drilling ahead Base Anhydrite 1612'
06-29 7:00 AM 2745' Drilling ahead
06-30 7:00 AM 3280' Drilling ahead
07-01 7:00 AM 3435' Drilling ahead
07-02 7:00 AM 3573' Testing
07-03 7:00 AM 3740' Plugging

RECEIVED
KANSAS CORPORATION COMMISSION

OCT 02 2008

CONSERVATION DIVISION
WICHITA, KS

PKT